

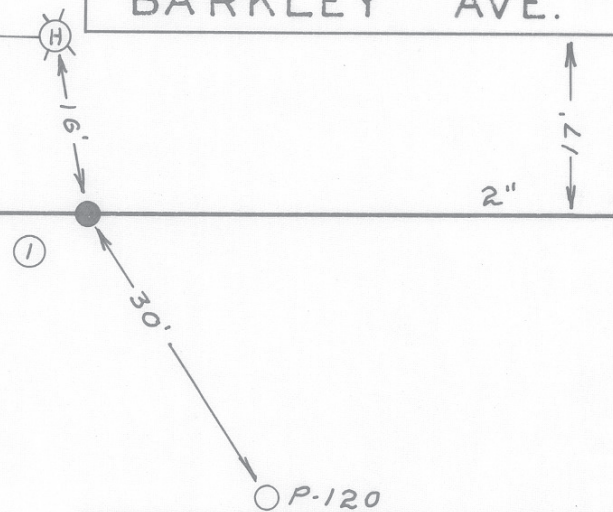
2/87 NP

WILLIAMSON RD.

12"

"6

"6"

[illegible]

CITY OF ROANOKE—WATER DEPT.
VALVE DIAGRAM

BARKLEY AVE. N.W. &
WILLIAMSON ROAD

SEC. MAP 210

DATE _____