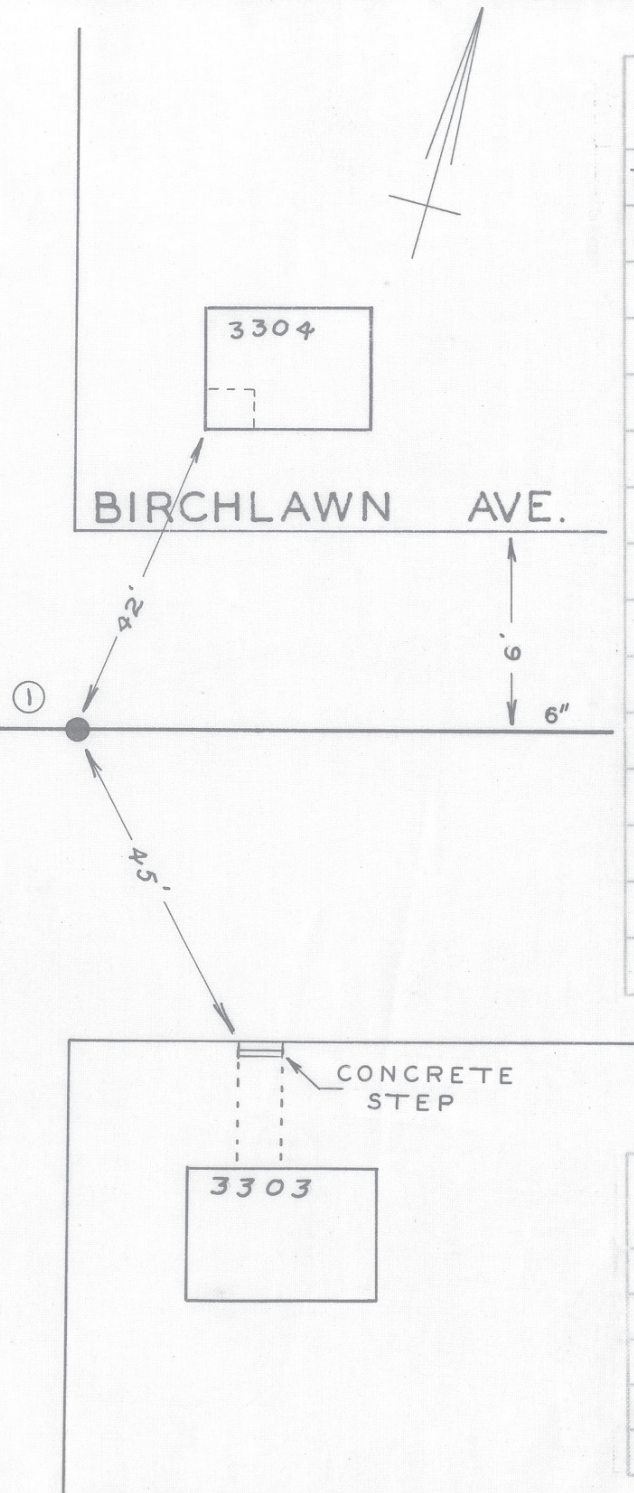


2/87 NP

WIN SLOE DRIVE

8"

8"

[illegible]

CITY OF ROANOKE - WATER DEPT.
VALVE DIAGRAM

BIRCHLAWN AVE. &
WINSLOE DRIVE N.W.

SEC. MAP 217

DATE _____