


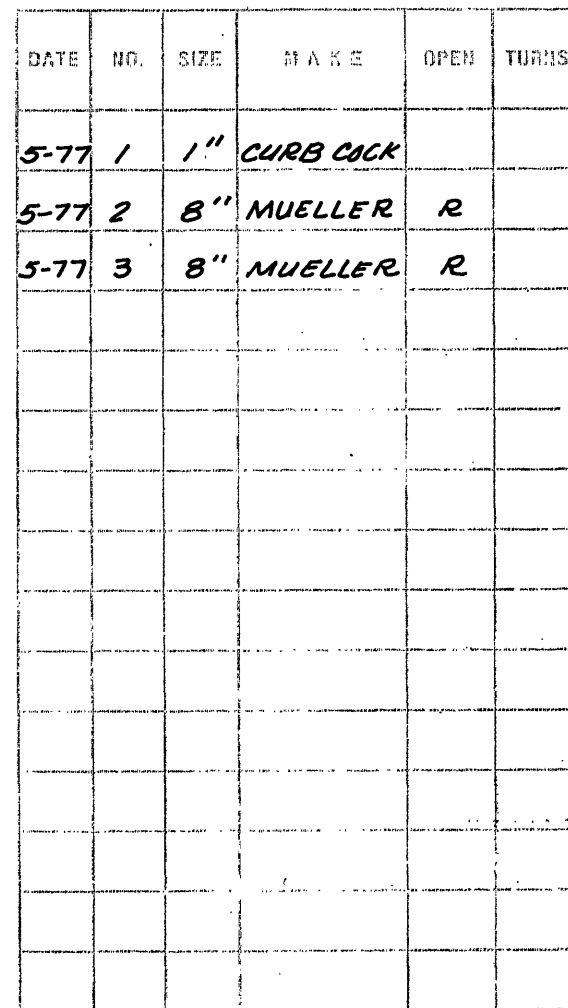

10/2000 JH