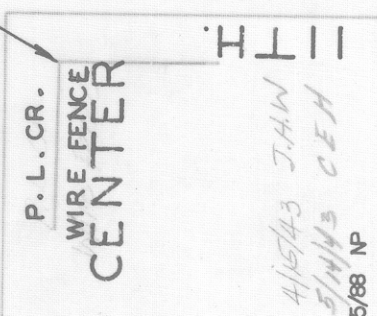


[illegible]

CITY OF ROANOKE—WATER DEPT	
VALVE DIAGRAM	
CENTER AVE & I1TH	
ST. N.W.	
SEC. MAP 211	
DATE	PAGE NO NW.88