


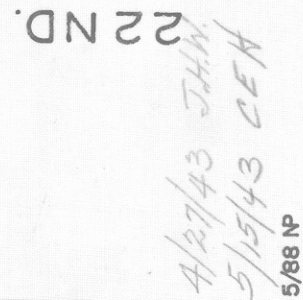

CITY OF ROANOKE—WATER DEPT
VALVE DIAGRAM
CENTER AVE. & 22ND.
ST. N. W.
SEC. MAP 231
DATE .
PAGE NO. NW 191