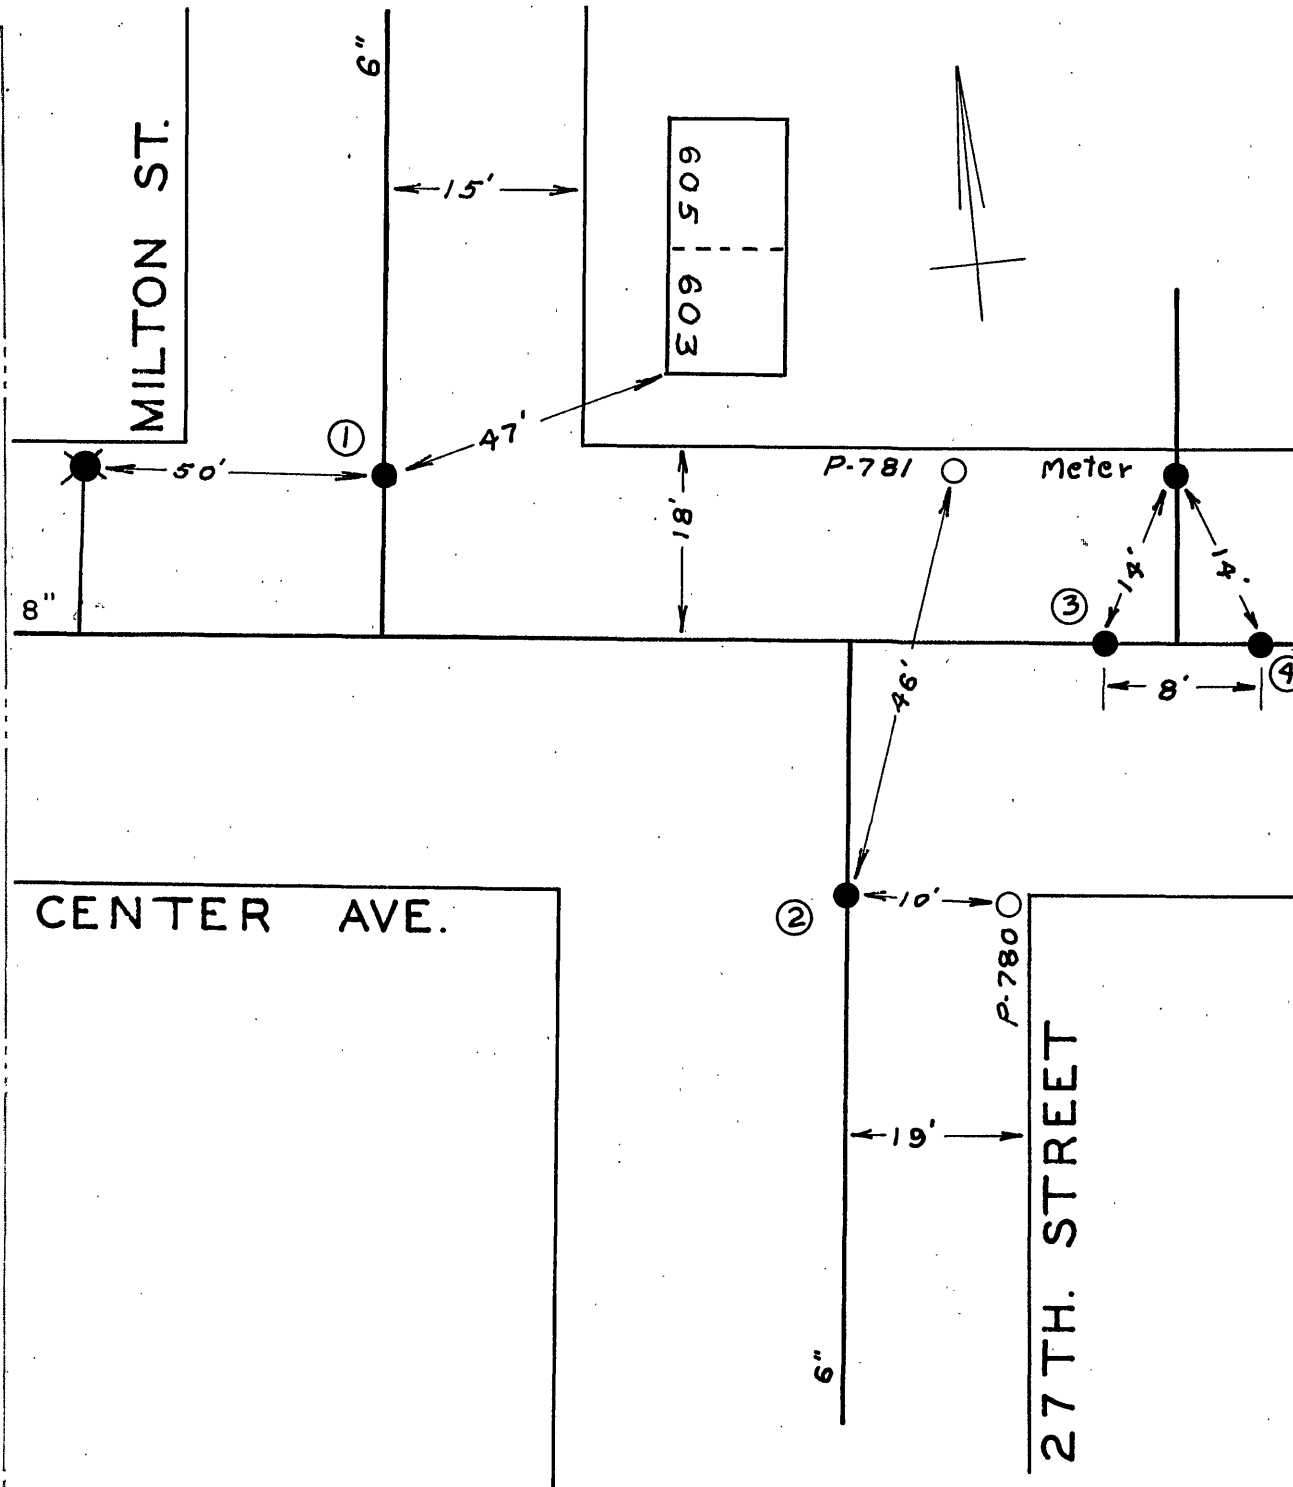


[illegible]

CENTER AVE

27th ST.

N. W.

DATE 11/11/78

PAGE NO.