


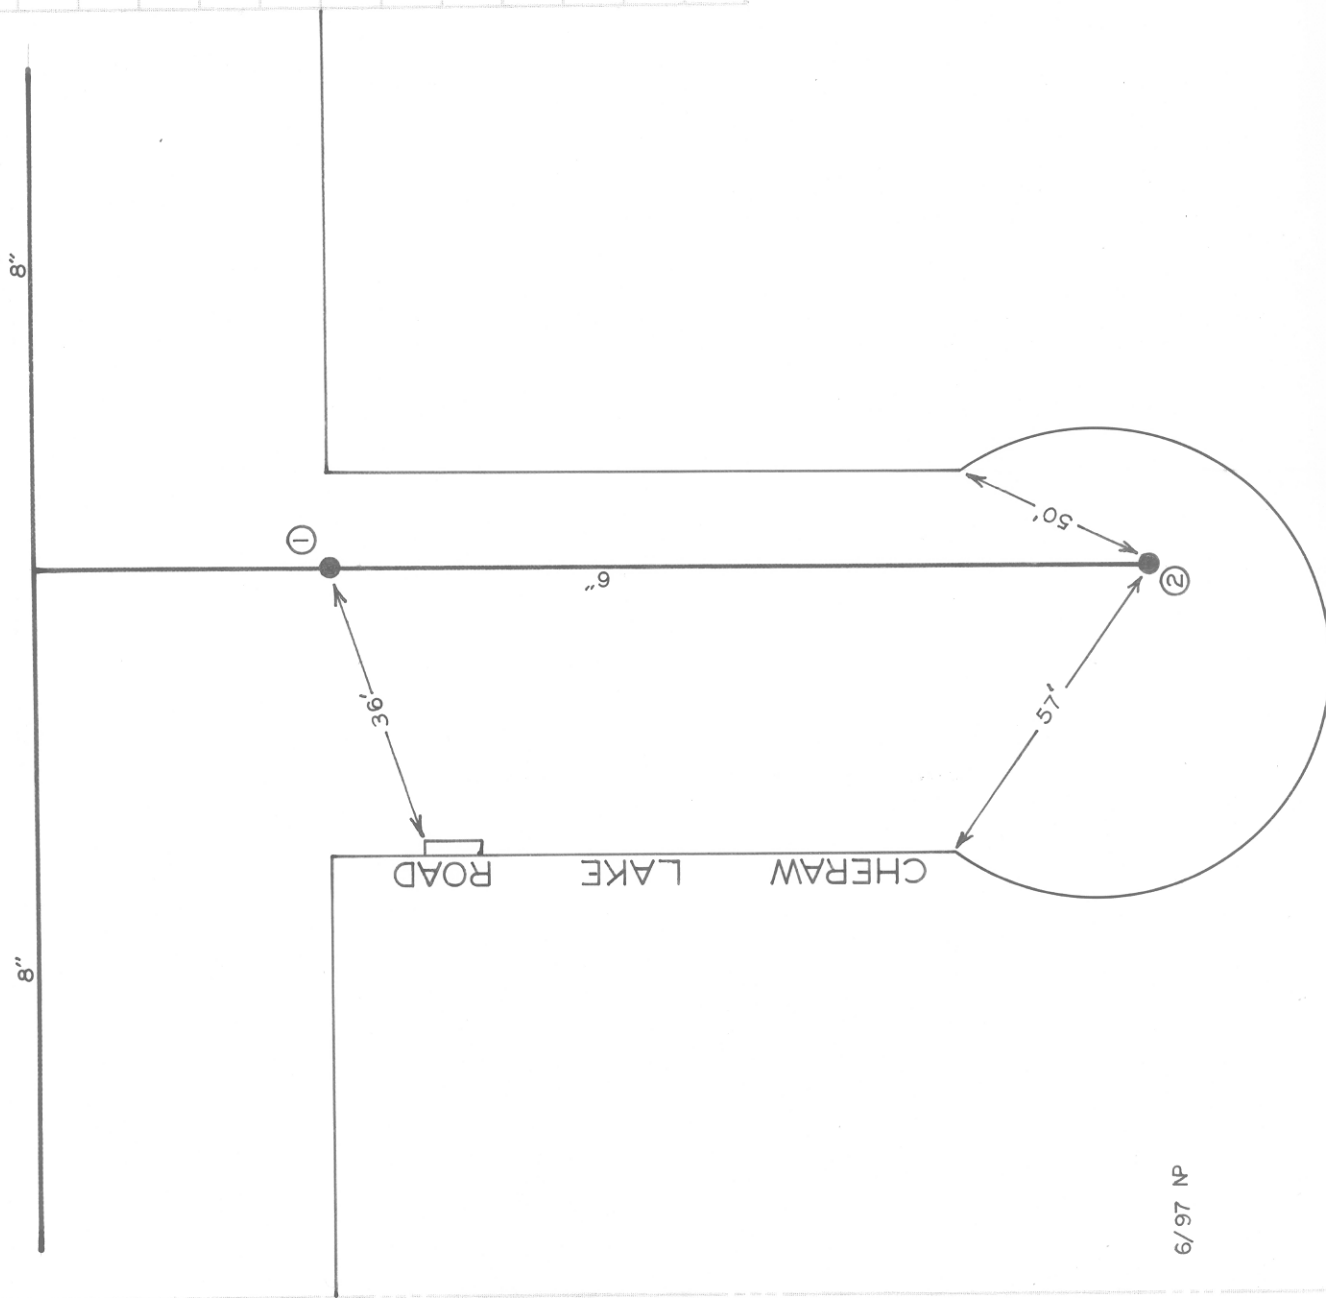

CITY OF ROANOKE -- WATER DEPT	
VALVE DIAGRAM	
CHERAW LAKE ROAD &	
LAUREL RIDGE ROAD N.W.	
SEC. MAP 649	(2)
DATE	PAGE NO.