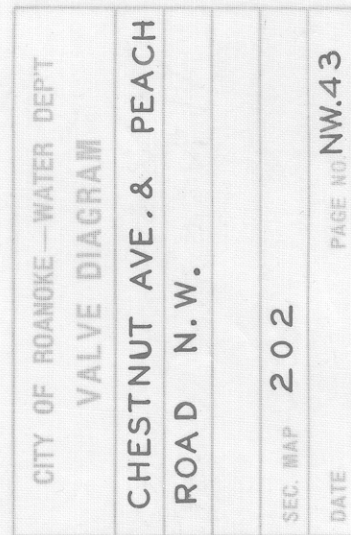


[illegible]

4/15/43 J.H.W.
5/14/43 C.E.H.