


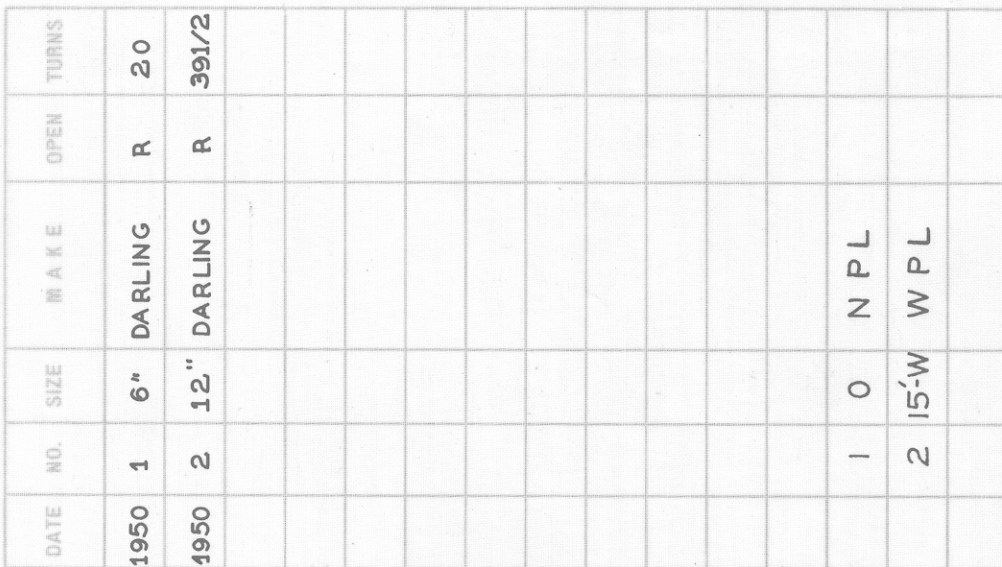

PAGE NO. NW368

MELROSE AVE.

5/88 NP