

CORNELL DRIVE

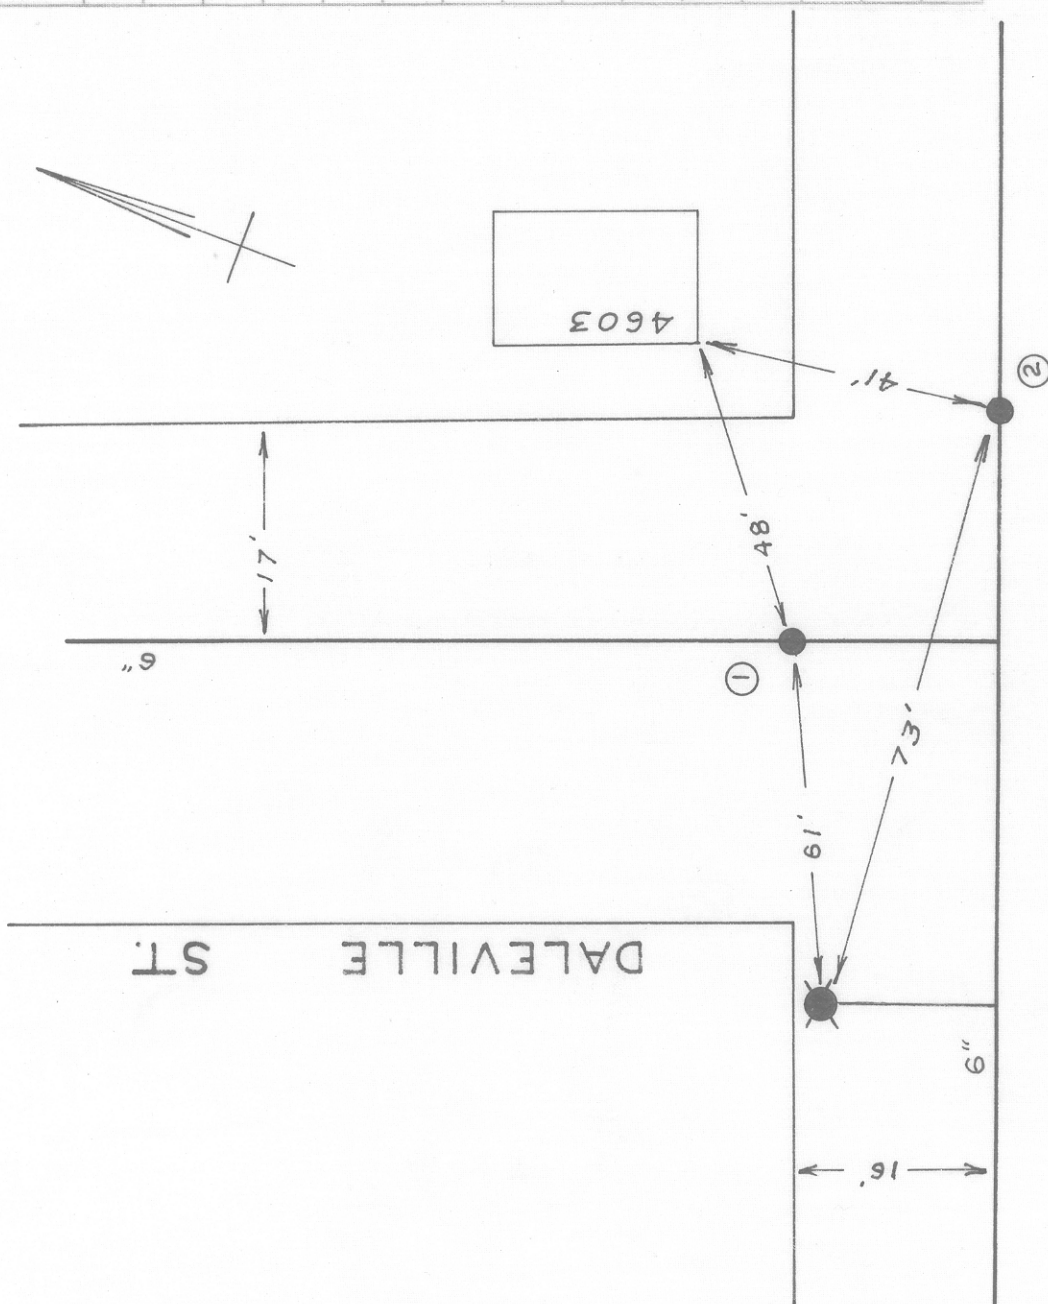
VALVE DIAGRAM

CORNELL DRIVE &

DALEVILLE ST. N.W.

SEC. MAP 228

DATE _____ PAGE NO. _____

[illegible]