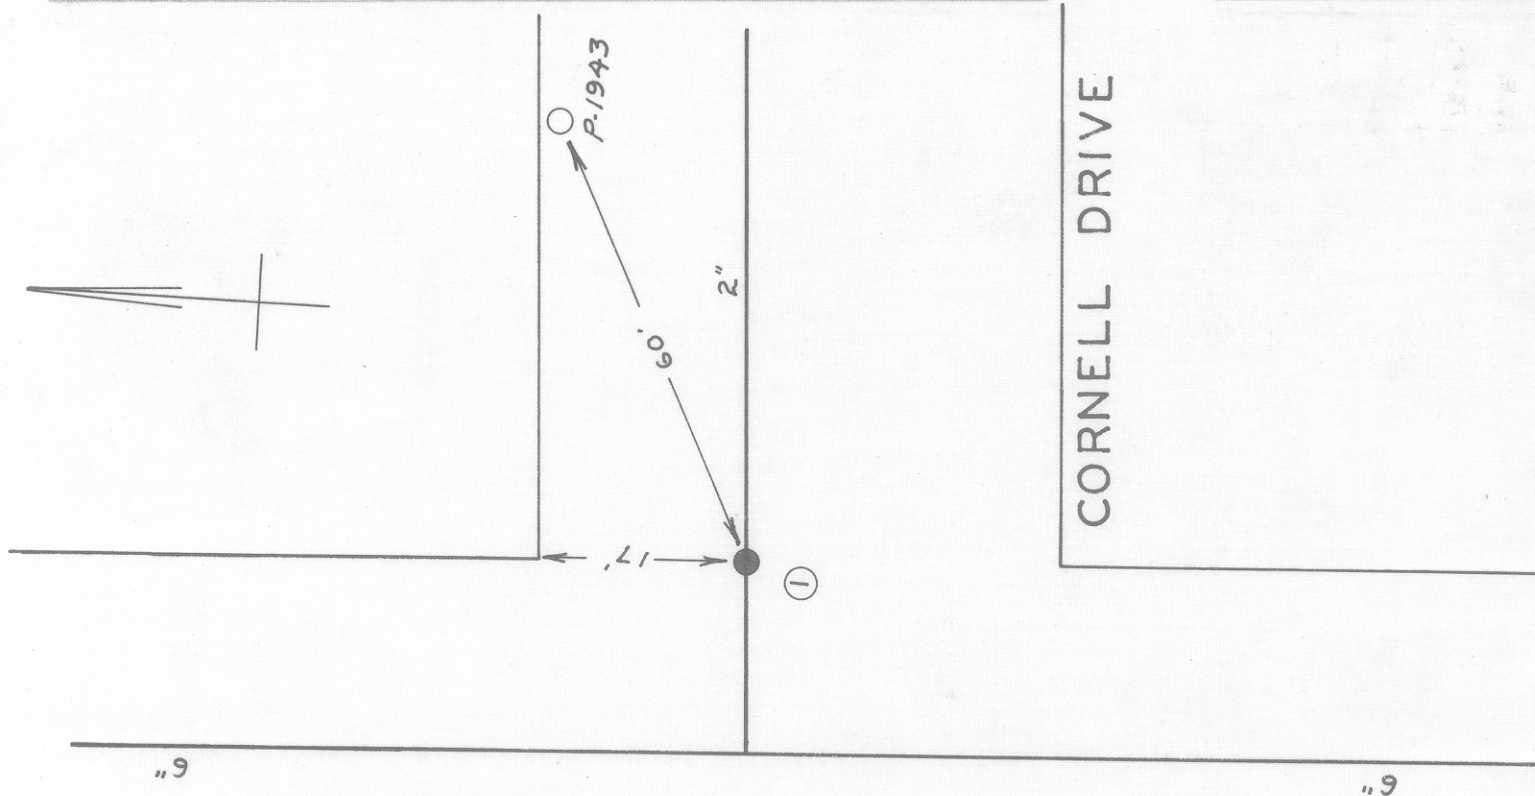


HUFF LANE AVE.

[illegible]

CORNELL DRIVE

CITY OF ROANOKE—WATER DEPT.

VALVE DIAGRAM

CORNELL DR. & HUFF LANE
AVE. N. W.

SEC. MAP 226

DATE PAGE NO.