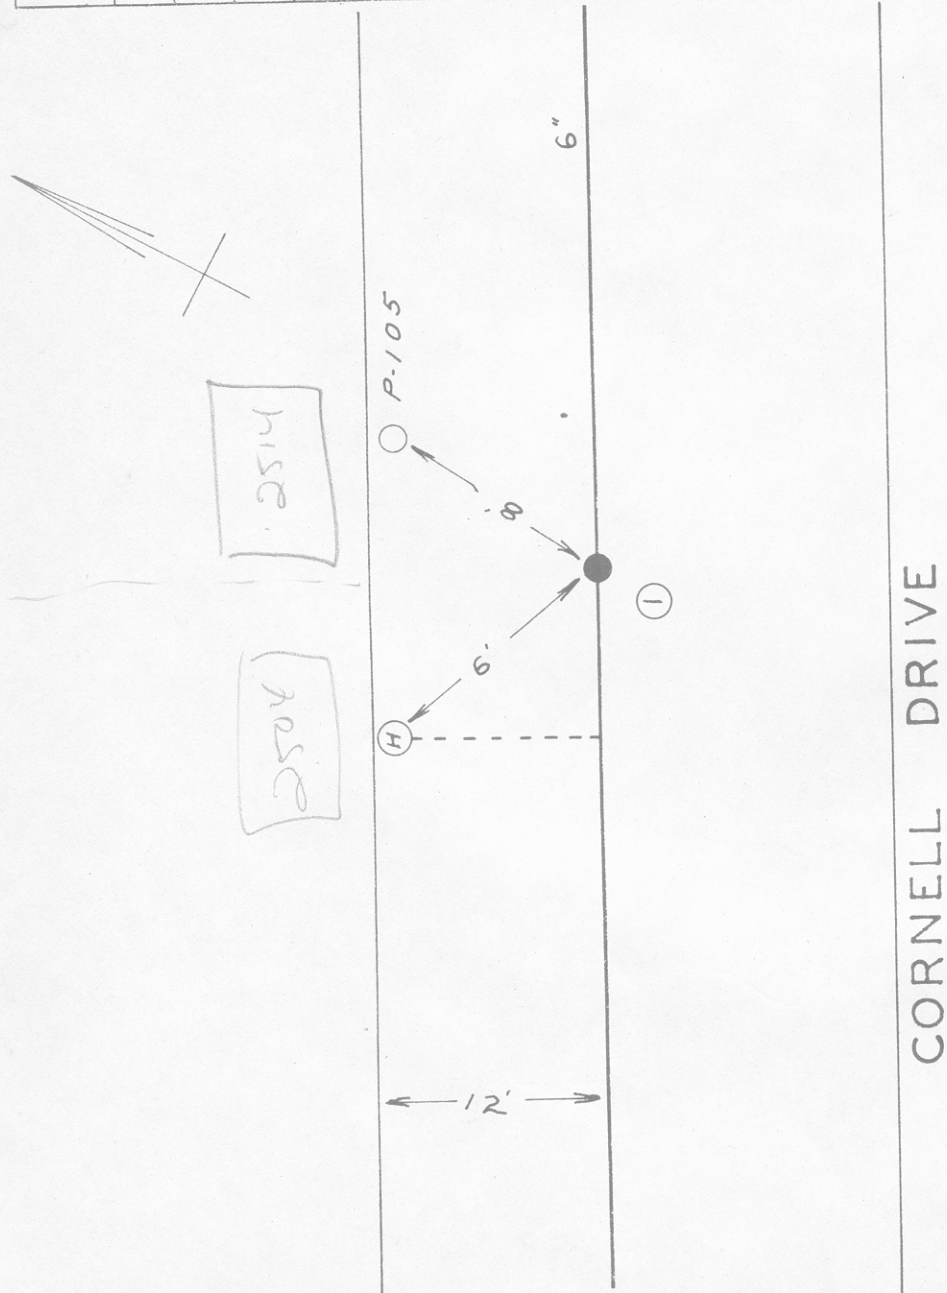


[illegible]

CITY OF ROANOKE—WATER DEPT.					
VALVE DIAGRAM					
CORNELL DR. W. OF					
GRANDVIEW AVE. N.W.					
SEC. MAP	226				
DATE					
PAGE NO.					

8/9/8