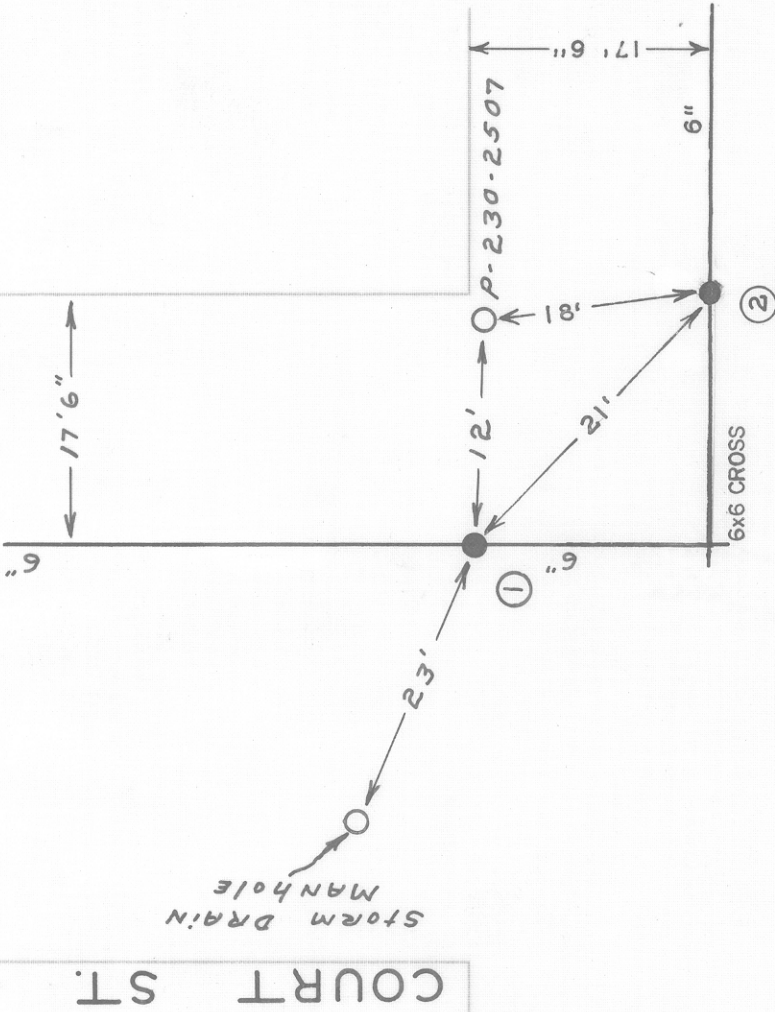


[illegible]

ROCKLAND AVE.

CITY OF ROANOKE—WATER DEPT

VALVE DIAGRAM

COURT ST. &

ROCKLAND AVE. N.W.

5/88 NP

SEC. MAP 213

DATE _____

CON
UN
CO
MI
D.