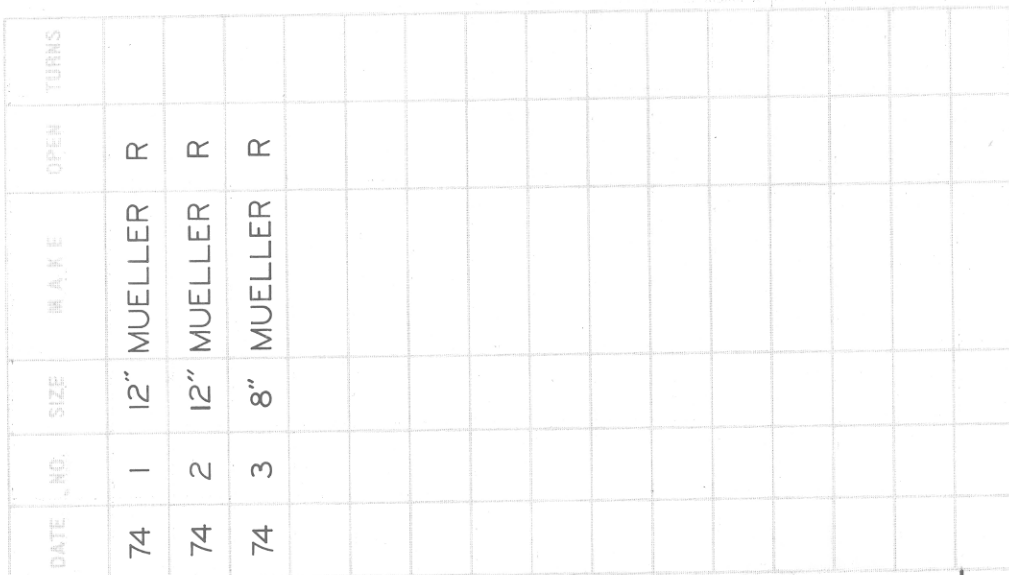


COVE ROAD &
PORTLAND AVENUE N.W.

641 SEC. MAP