


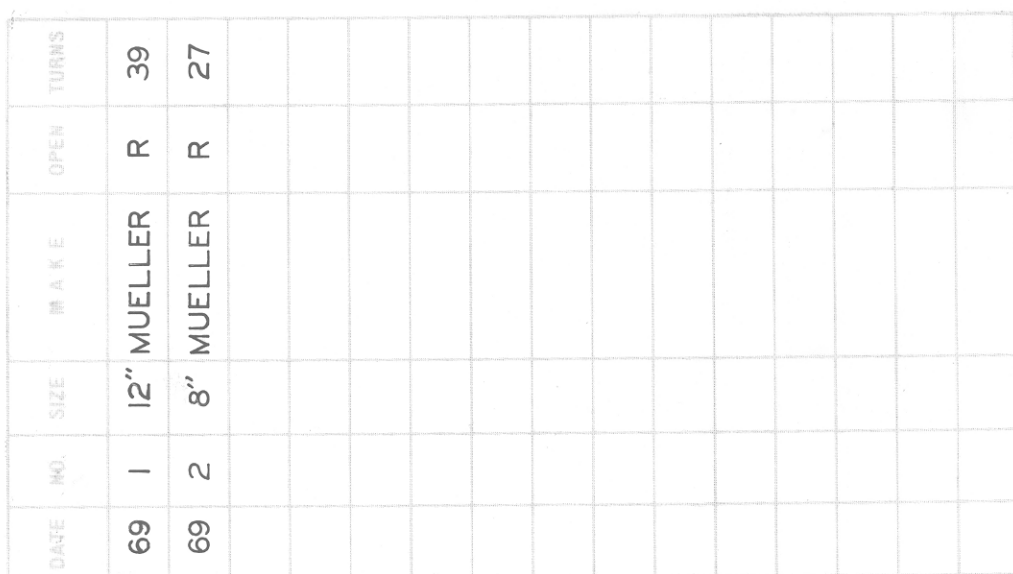

ROAD

COVE

PN 26/9

COVE ROAD & RANCH ROAD N.W.

SEC. MAP 643