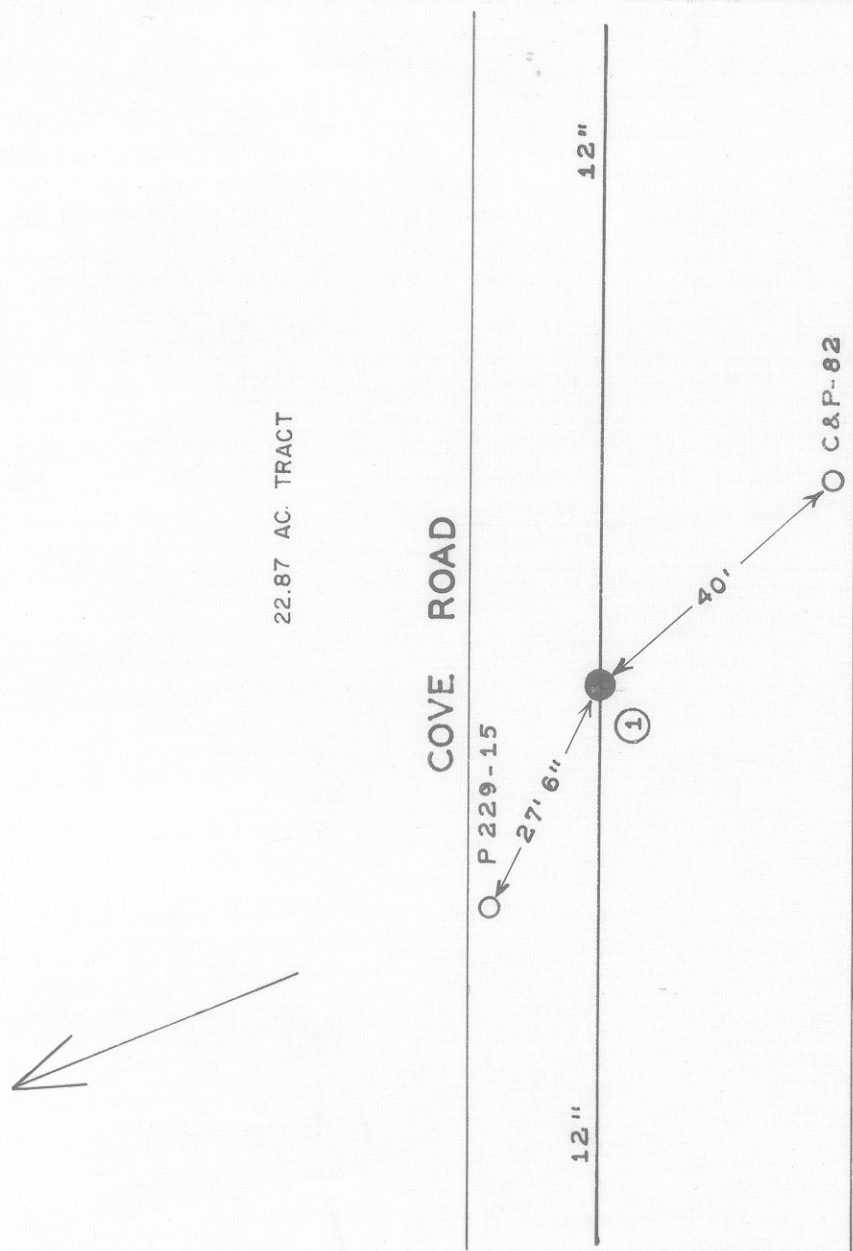


K & S CO., N. Y.

5/97 NP

~~3402~~

2,814 AC. TRACT

[illegible]

CITY OF ROANOKE — WATER DEPT.

VALVE DIAGRAM

COVE ROAD 700' N.W. OF

HERSHBERGER ROAD N.W.

SEC. NAP 644

(2)

DATE: PAGE NO.