


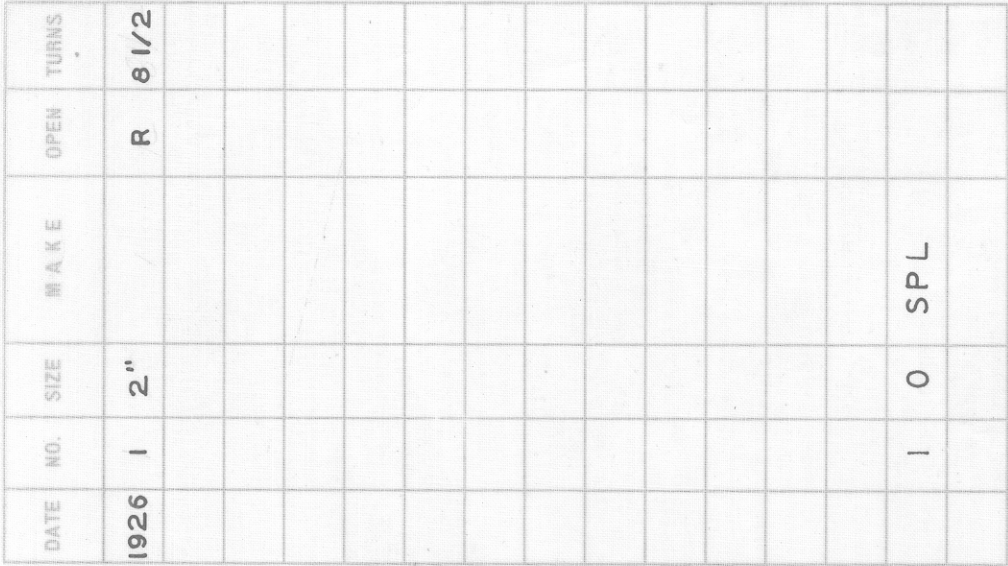

DATE PAGE NO. NW 263