


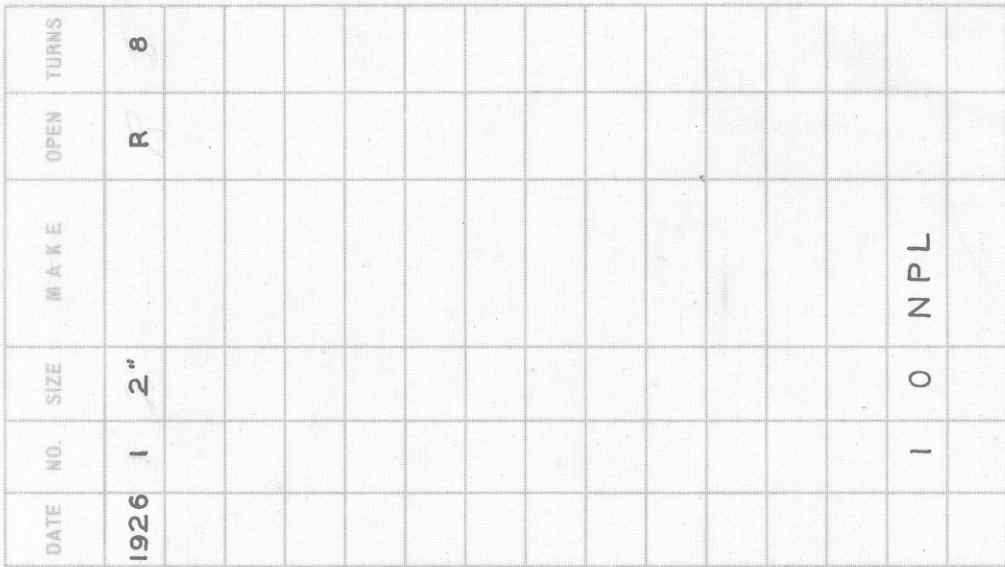

CITY OF ROANOKE—WATER DEPT	
VALVE DIAGRAM	
CRESCENT STREET & 1 ST AVE	
MELROSE AVENUE	N.W.
SEC. MAP	243,242
DATE	PAGE NO NW245

5/7/43 J.H.W.
5/88 NP