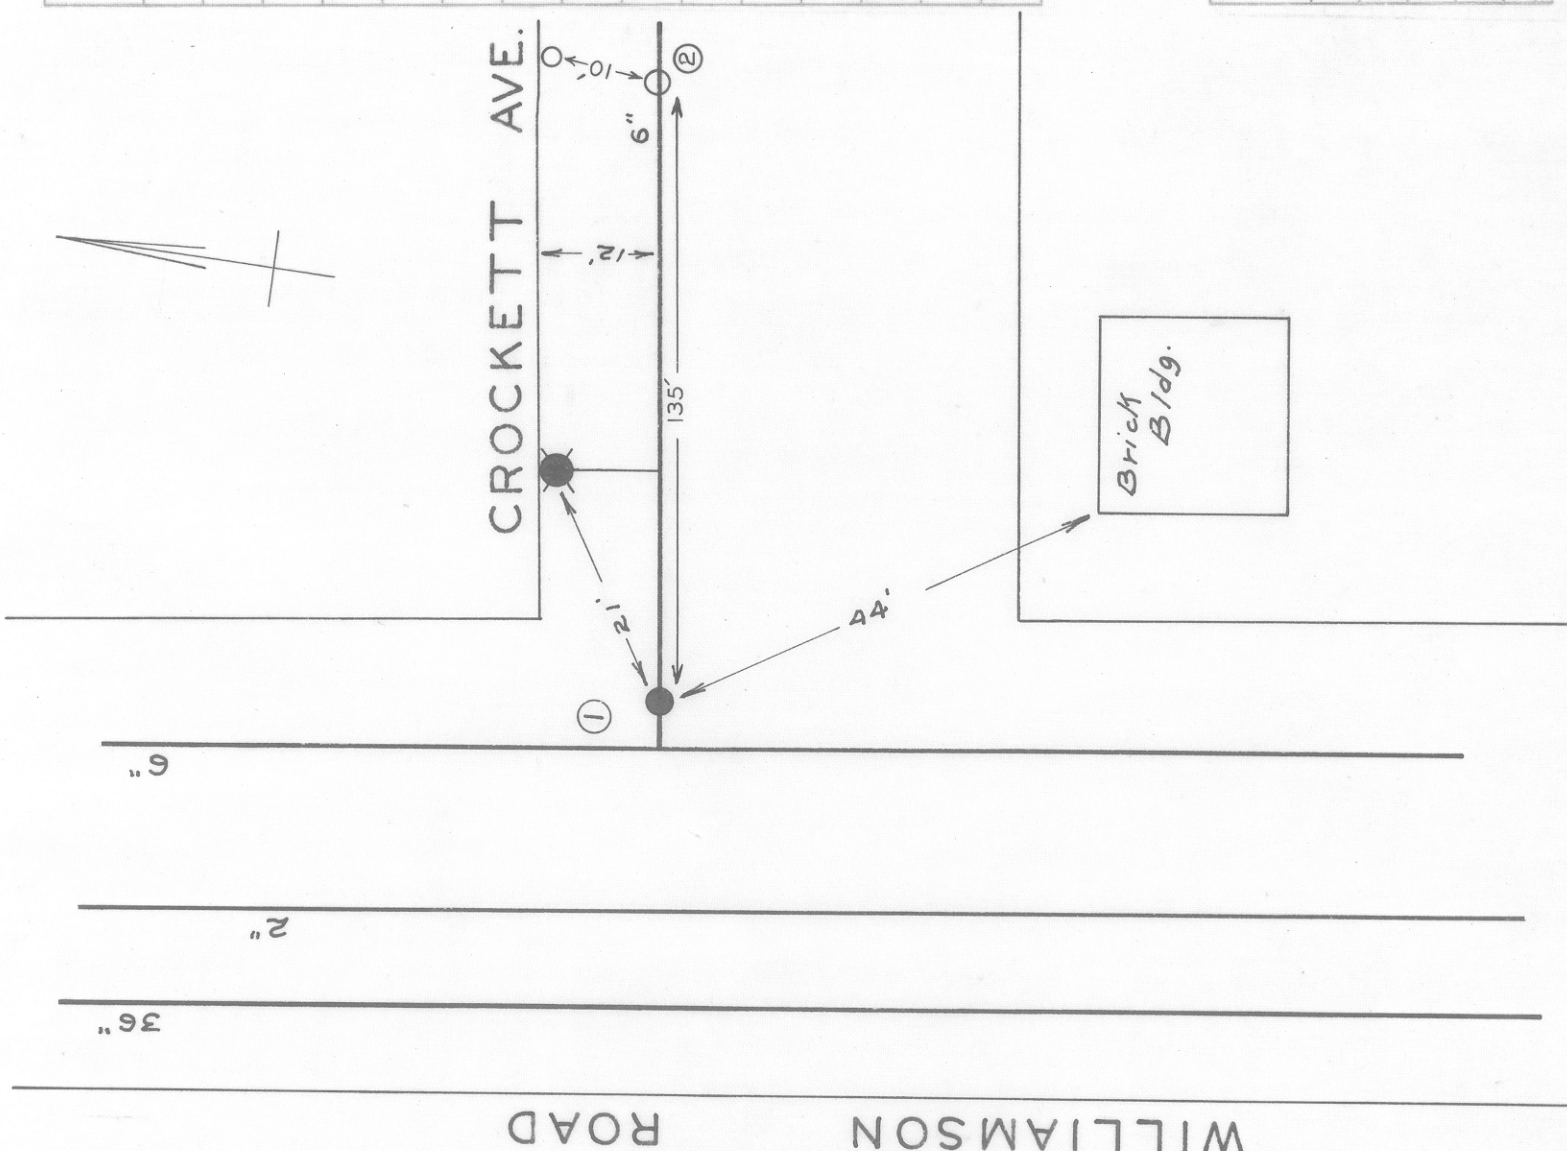


[illegible]

CITY OF ROANOKE—WATER DEPT.

VALVE DIAGRAM

CROCKETT AVE. &

WILLIAMSON RD. N.W.

SEC. MAP 209

DATE _____ W.R. _____

PAGE NO.