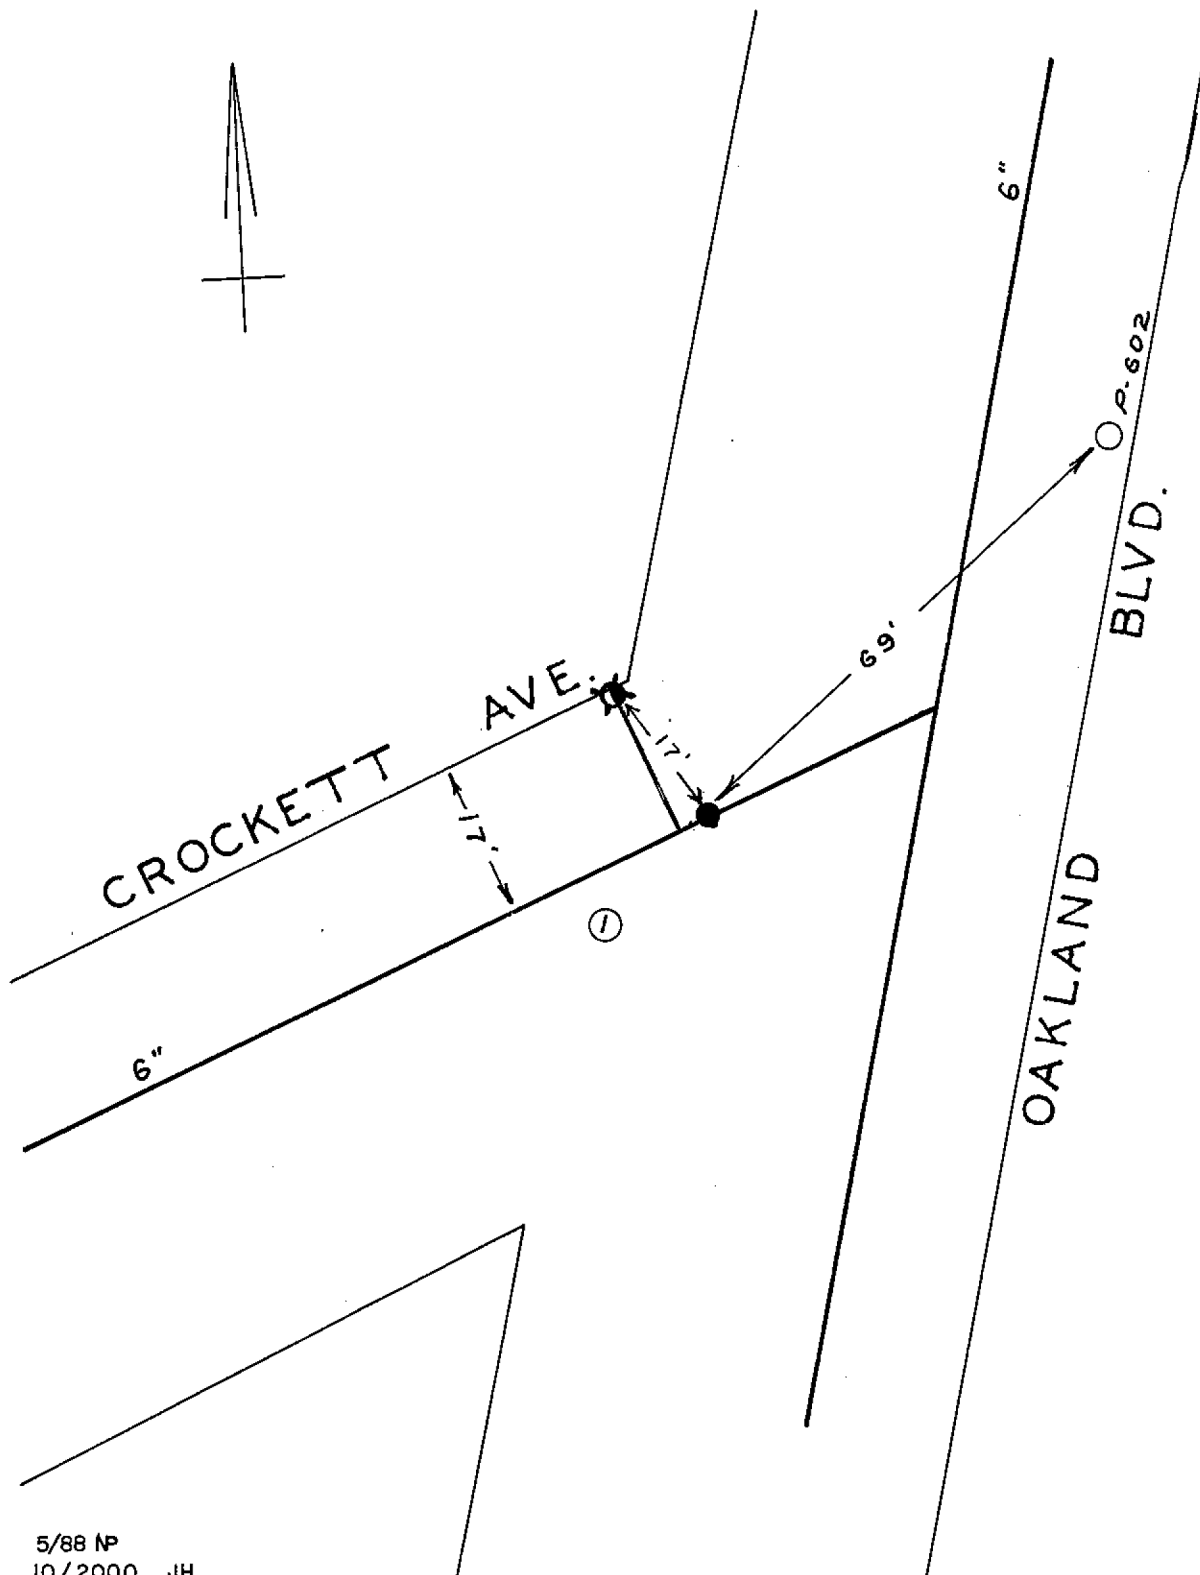


[illegible]

ONE OF ROOMS - WOOD HILL
 VALUE DIAGRAM
 CROCKETT AVE. &
 OAKLAND BLVD. N. W. OR.
 N. E.
 SEP PAP 209,317
 LOTF 500000