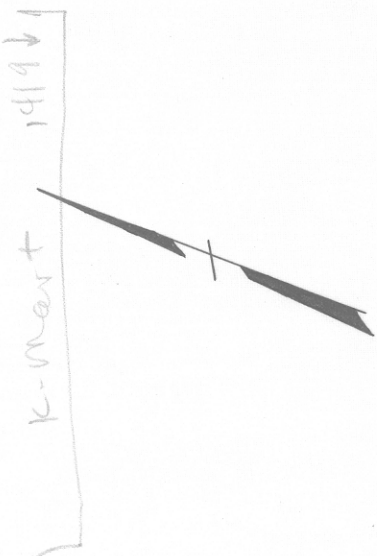


K & S CO., N. Y.

[illegible]

CITY OF ROANOKE -- WATER DEPT.			
VALVE DIAGRAM			
CROSSROADS SHOPPING			
CENTER-AT S.W. COR.			
OF BUILDING			
SEC. MAP 36			
DATE			
PAGE NO.			