


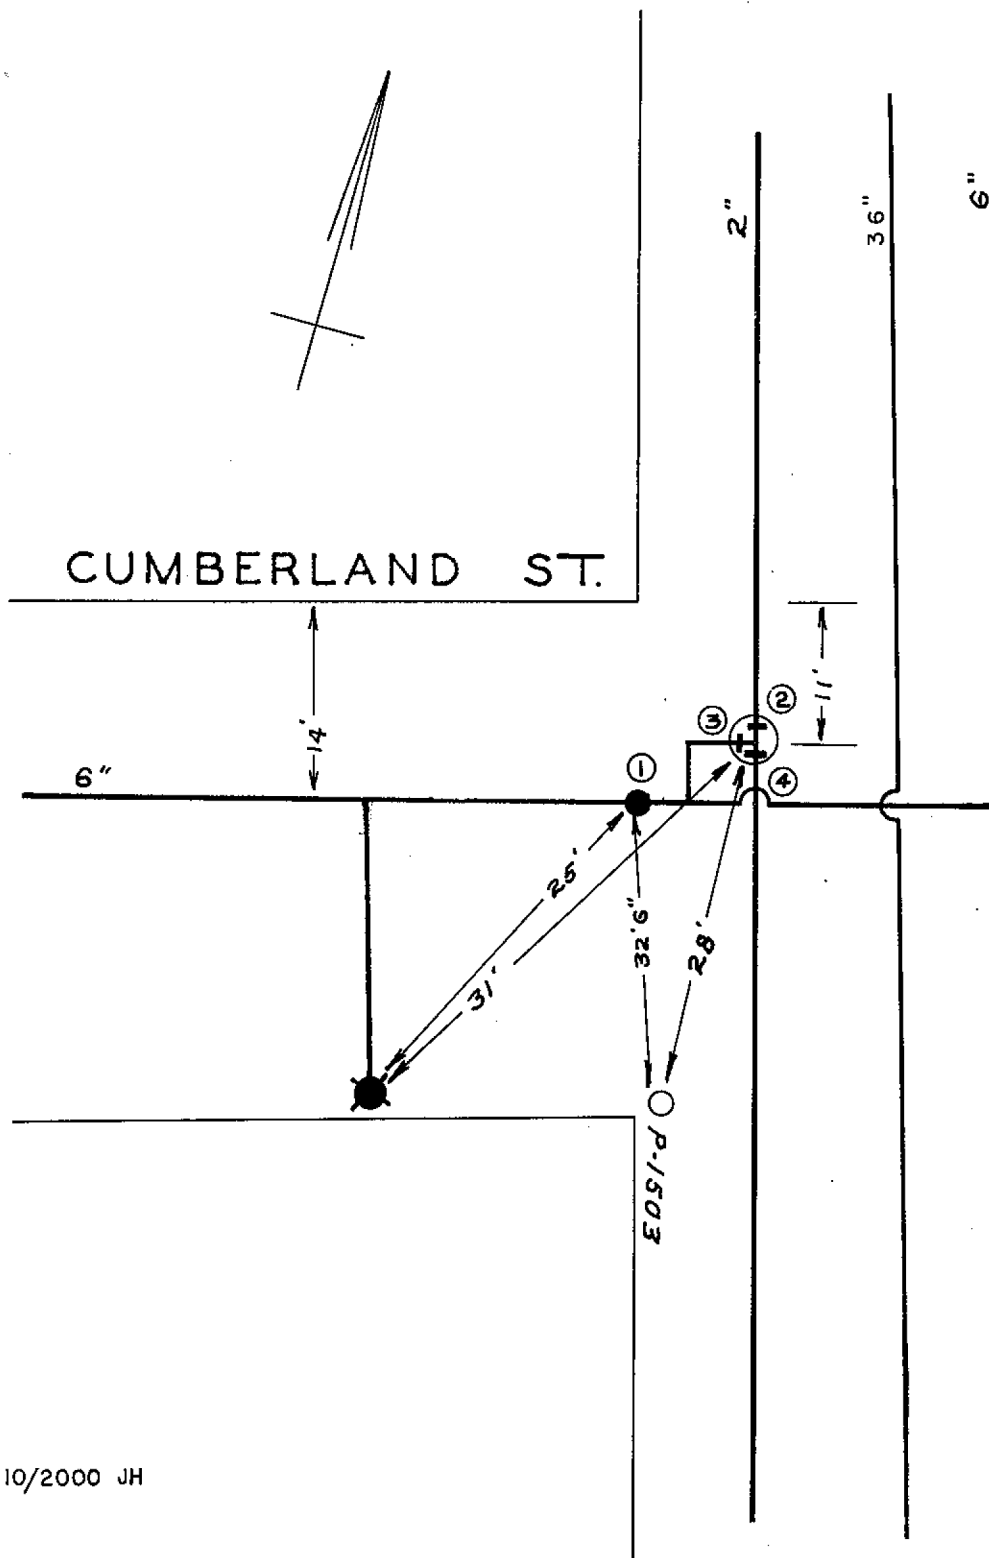

DATE	NO.	SIZE	NAME	OPEN	TURNS
	1	6"			
	2	2" 3"			
	3	2"			
	4	2" 3"			
	1	0	WPL		
	2	5'-E	WPL		
	3	5'-E	WPL		
	4	5'-E	WPL		

[illegible]