


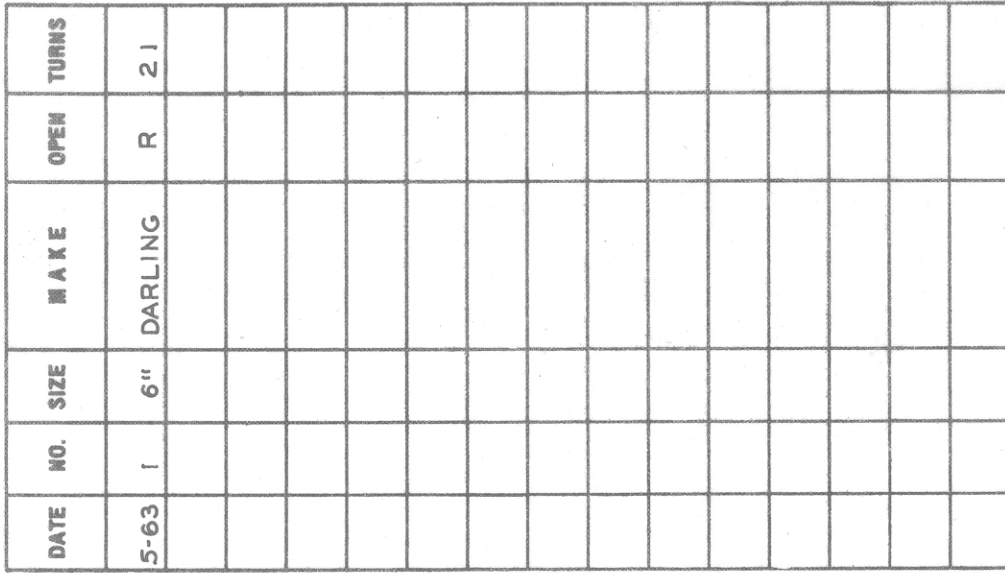

CITY OF ROANOKE — WATER DEPT.
VALVE DIAGRAM

DESI DRIVE &
THRUSH DRIVE

SEC. MAP 606

N.W.

DATE PAGE NO.

1/2001 JH