


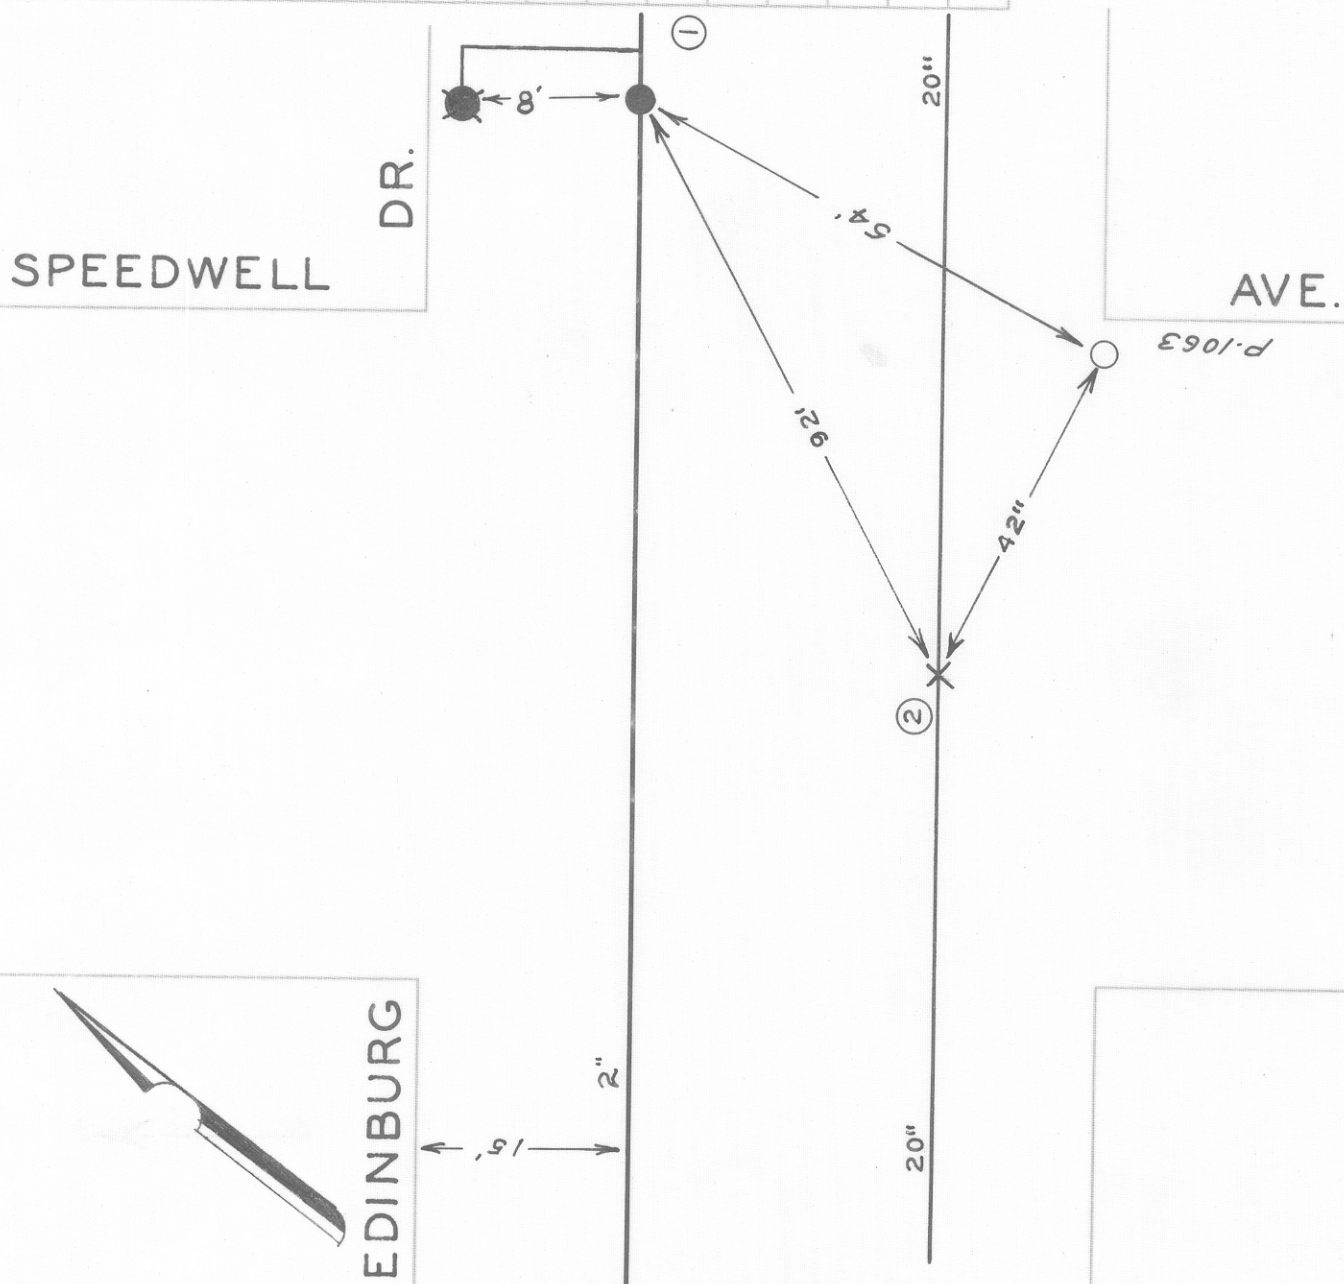

CITY OF ROANOKE—WATER DEPT
VALVE DIAGRAM
EDINBURG DRIVE &
SPEEDWELL AVE.

SEC. MAP 227
N.W.

DATE

PAGE NO.