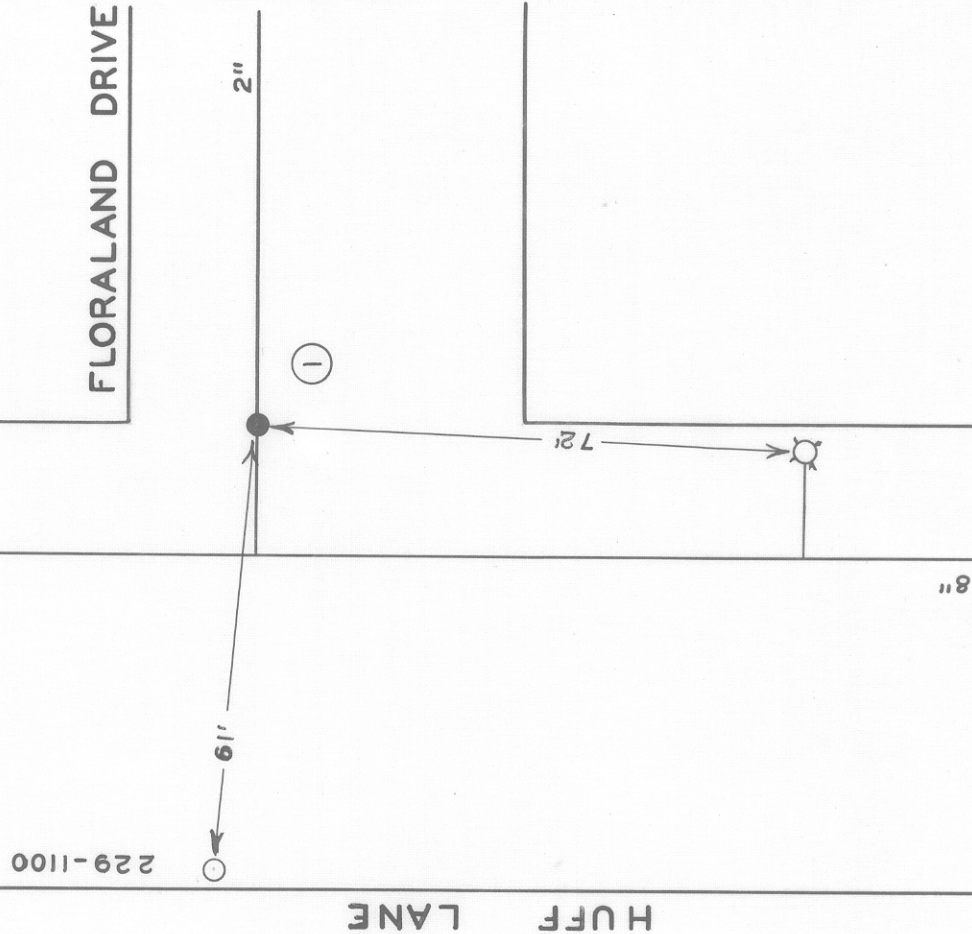


FLORALAND DRIVE

[illegible]

CITY OF ROANOKE — WATER DEPT.

VALVE DIAGRAM

FLORALAND DRIVE &

HUFF LANE N.W.

SEC. MAP 226

DATE _____

PAGE NO.