


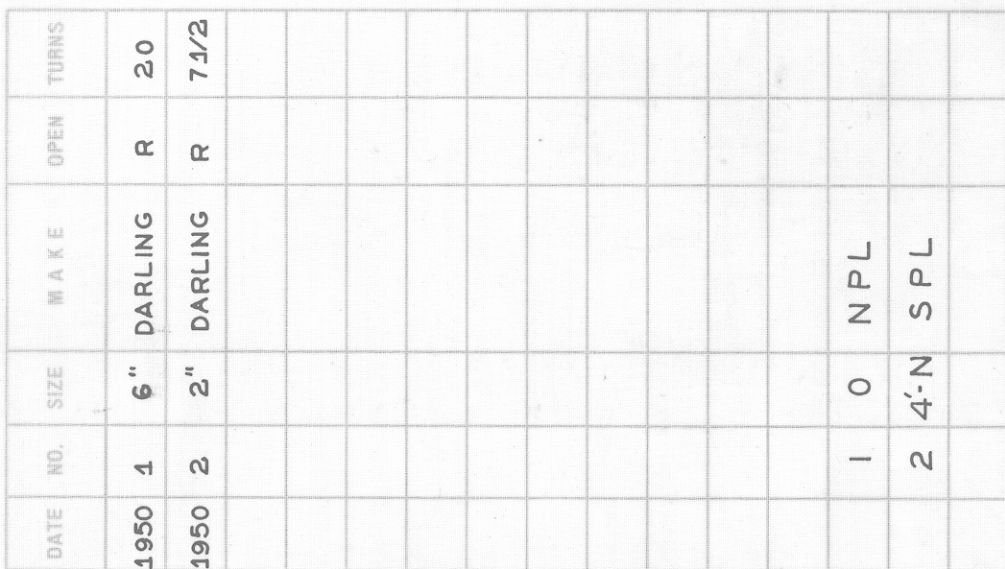

PAGE NO. NW 283