


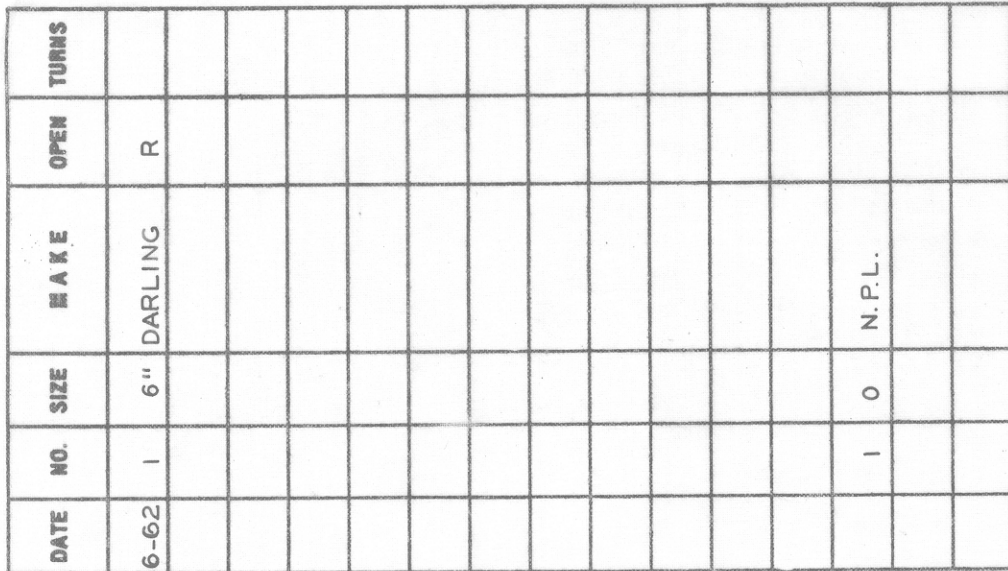

VALVE DIAGRAM

FRONTIER ROAD N.W.

DATE _____

PAGE NO.