


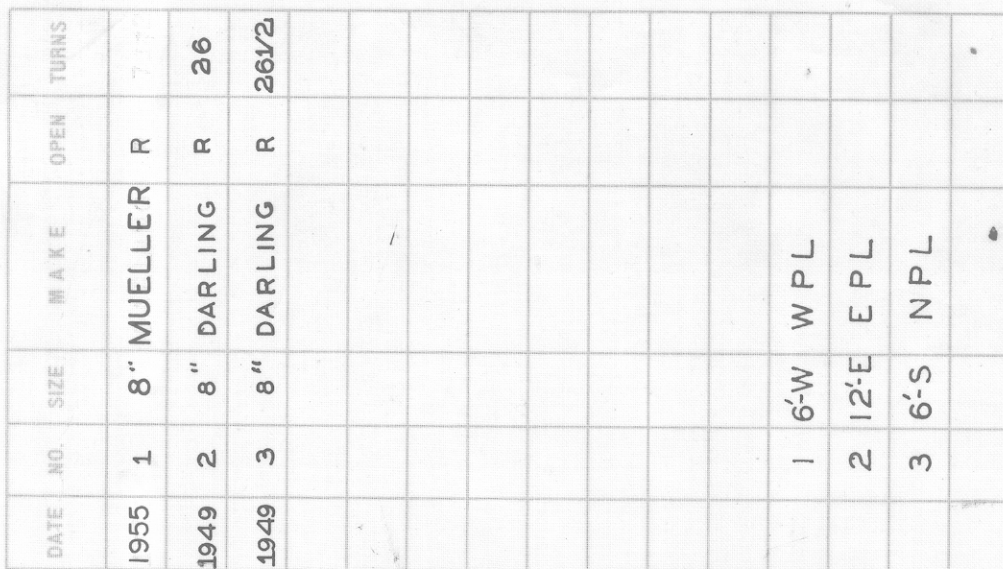

PARK BLVD.

(CLOSED)

11/2000 JH

CITY OF ROANOKE—WATER DEPT
VALVE DIAGRAM

FOREST PARK BLVD. &

GUILDHALL AVE. N.W.

SEC. MAP 246, 256 N.W.

DATE 2/23/50 PAGE NO. NW323