


STATE	NO	SIZE	MAKE	OPEN	TURNS
70	1	16"	DARLING	R	
70	2	16"	MUELLER	R	
70	3	16"	MUELLER	R	
70	4	8"	MUELLER	R	
70	5	8"	MUELLER	R	
70	6	8"	MUELLER	R	

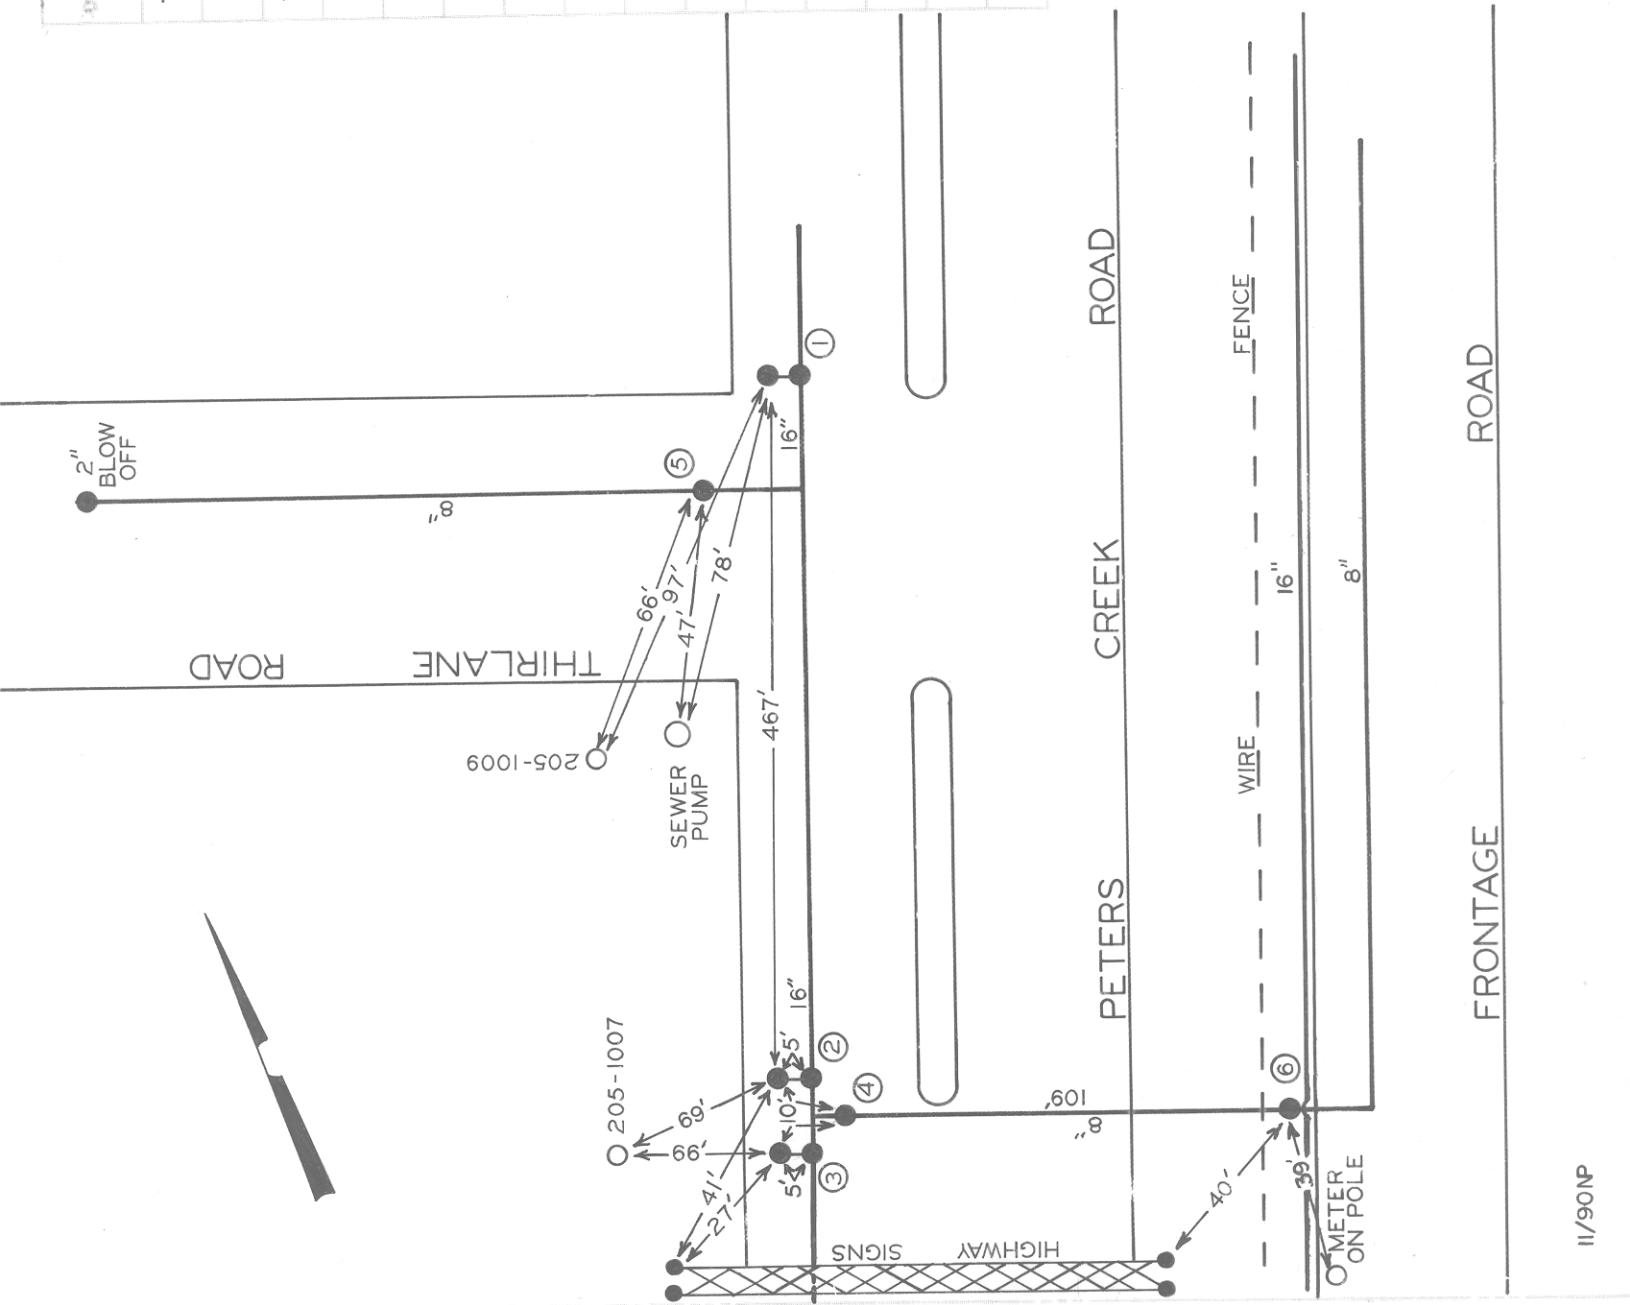

CITY OF ROANOKE — WATER DEPT.	VALVE DIAGRAM
FRONTAGE ROAD & PETERS	CREEK ROAD & THIRLANE
ROAD N.W.	ROAD
SEC. MAP 649, COUNTY # 79	PAGE NO.
DATE	11/90NP