


2775

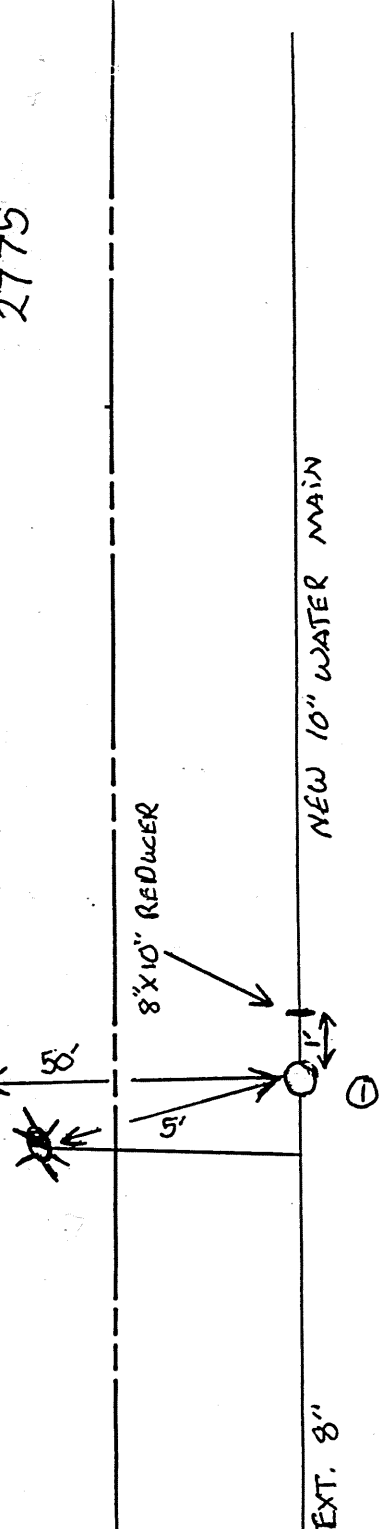

Frontage Road

[illegible]

VALVE DIAGRAM

2700 Block of FRONTAGE
ROAD NW.

SEC. MAP 645

DATE: 8-26-99

PAGE NO.