


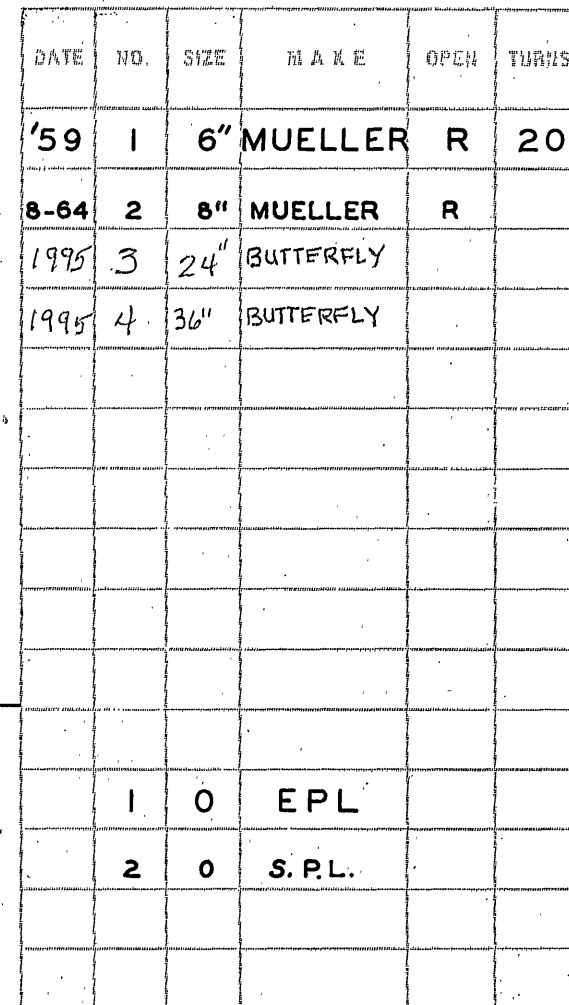

DATE PAGE NO.

11/2000 JH