


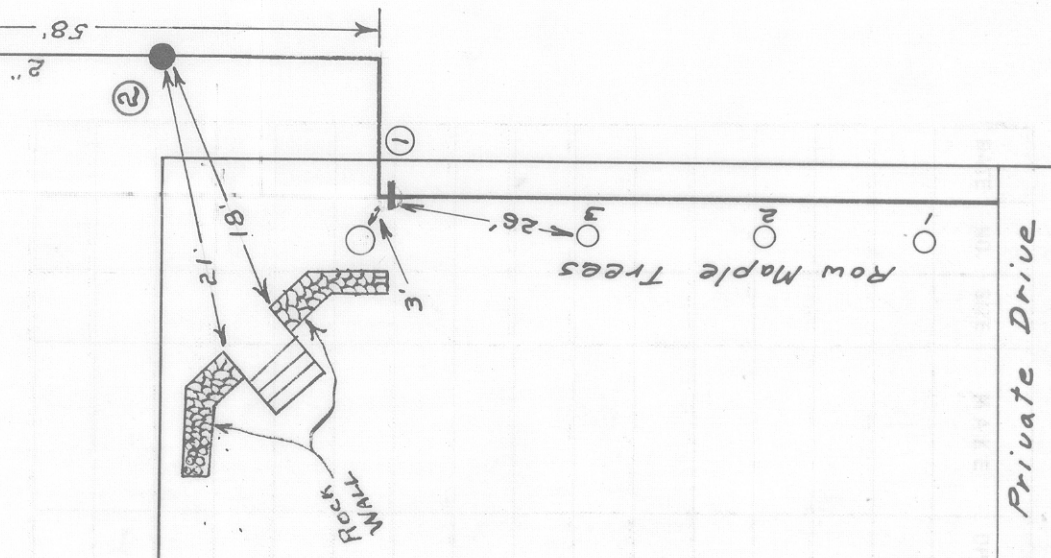

12"

GILBERT ROAD

[illegible]

CITY OF ROANOKE — WATER DEPT.

VALVE DIAGRAM

GILBERT RD. &

HERSHBERGER RD. N.W.

SEC. MAP 267

DATE PAGE NO.