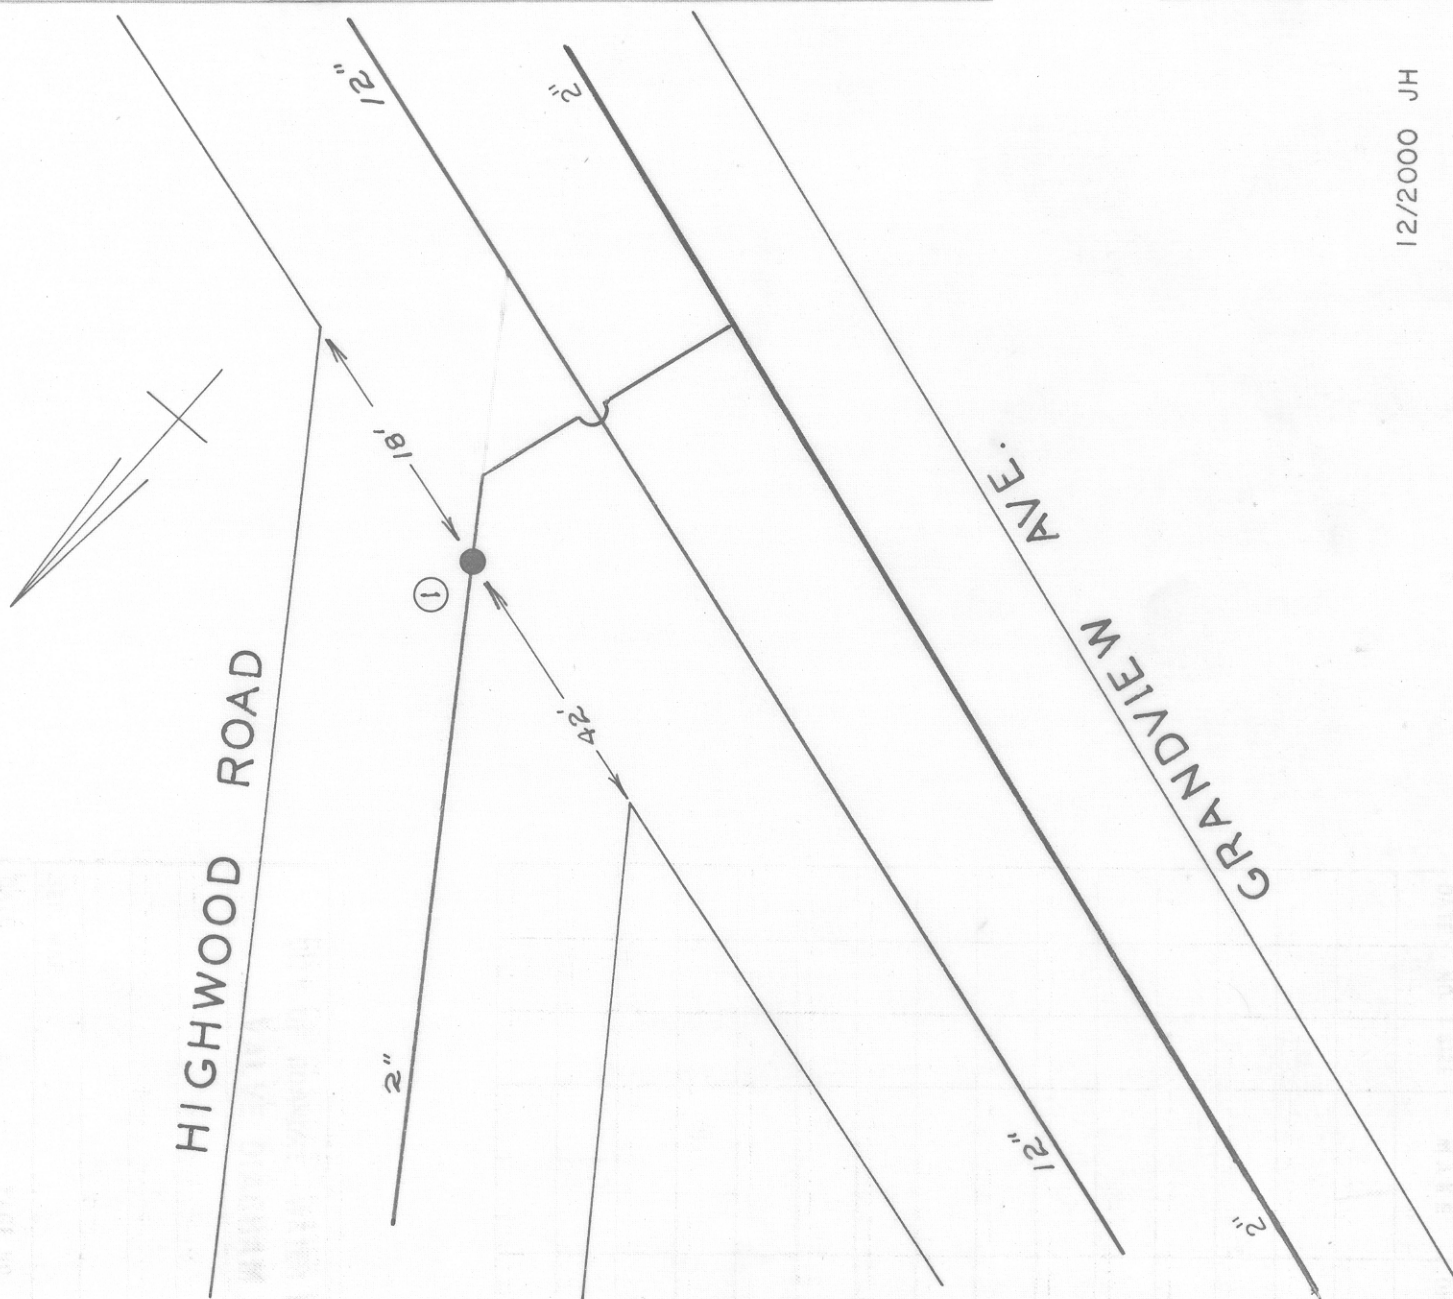


[illegible]

CITY OF ROANOKE — WATER DEPT.

VALVE DIAGRAM

GRANDVIEW AVE. &

HIGHWOOD RD.

SEC. MAP 215. N. W.

DATE PAGE NO.

12/2000 JH