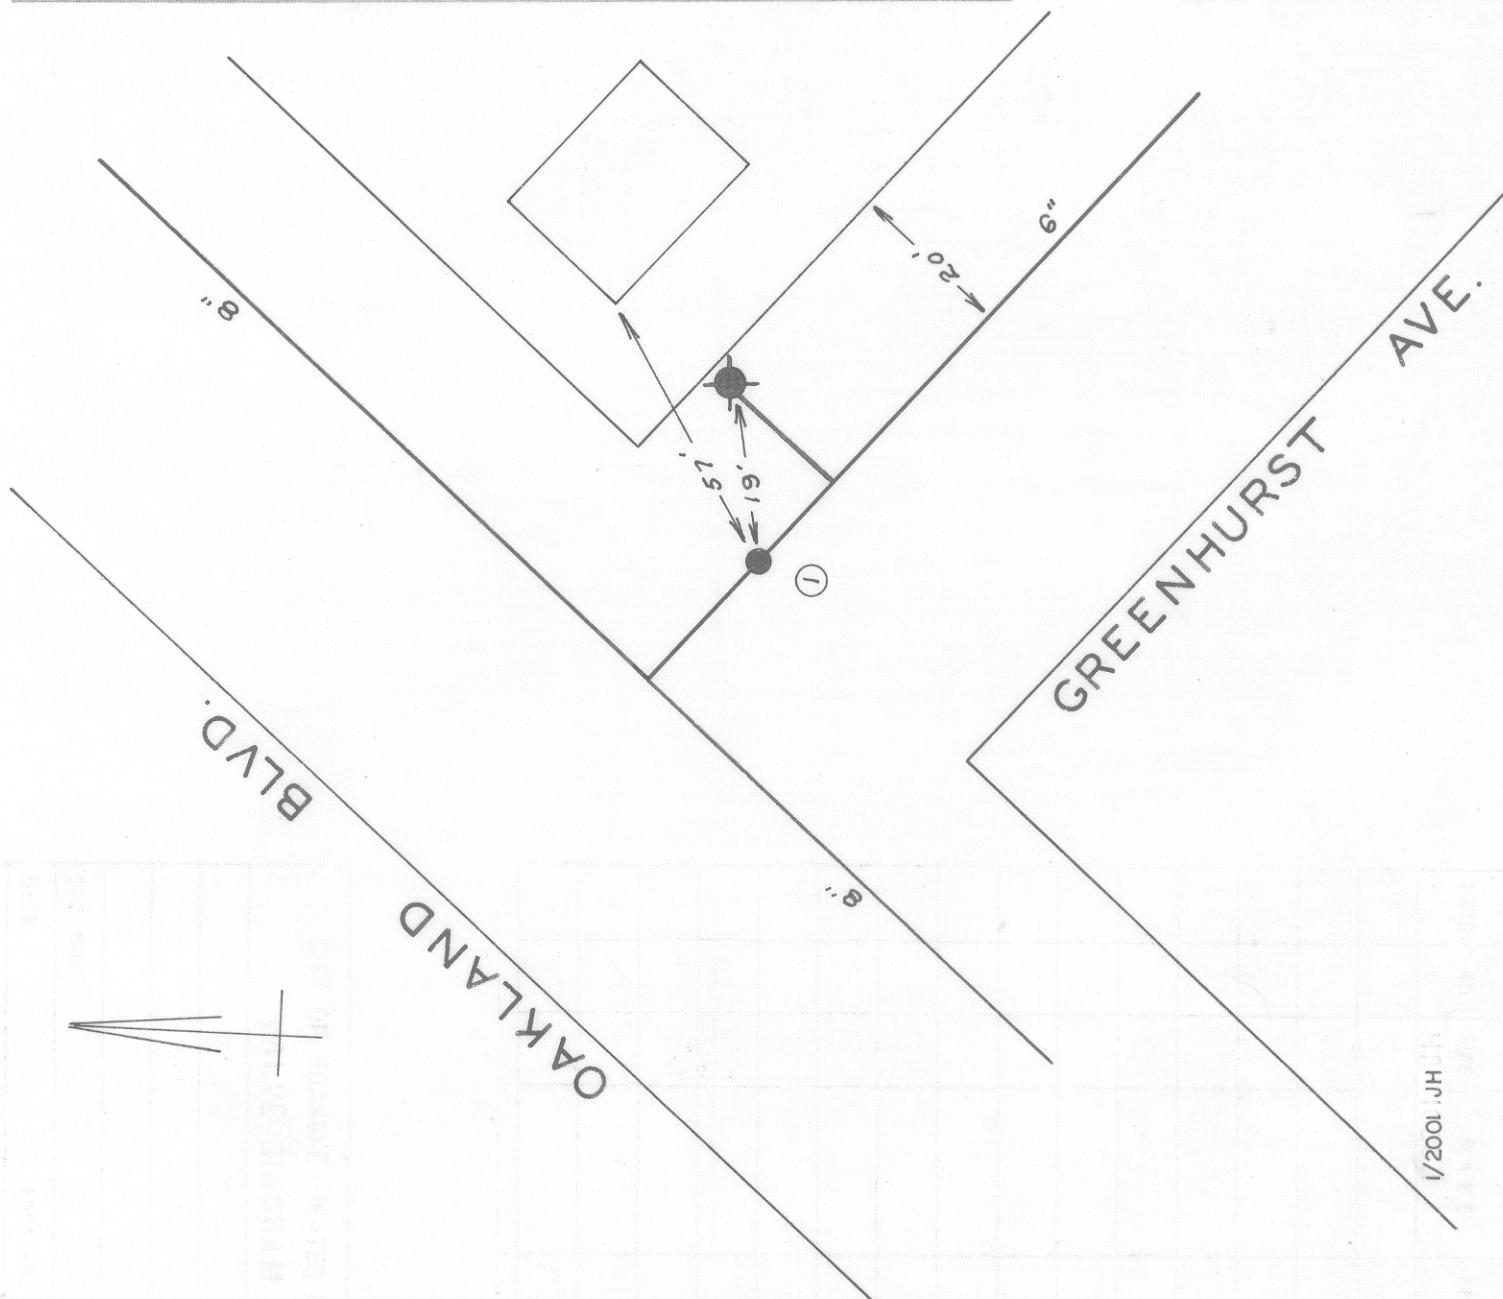


[illegible]

CITY OF ROANOKE—WATER DEPT.