


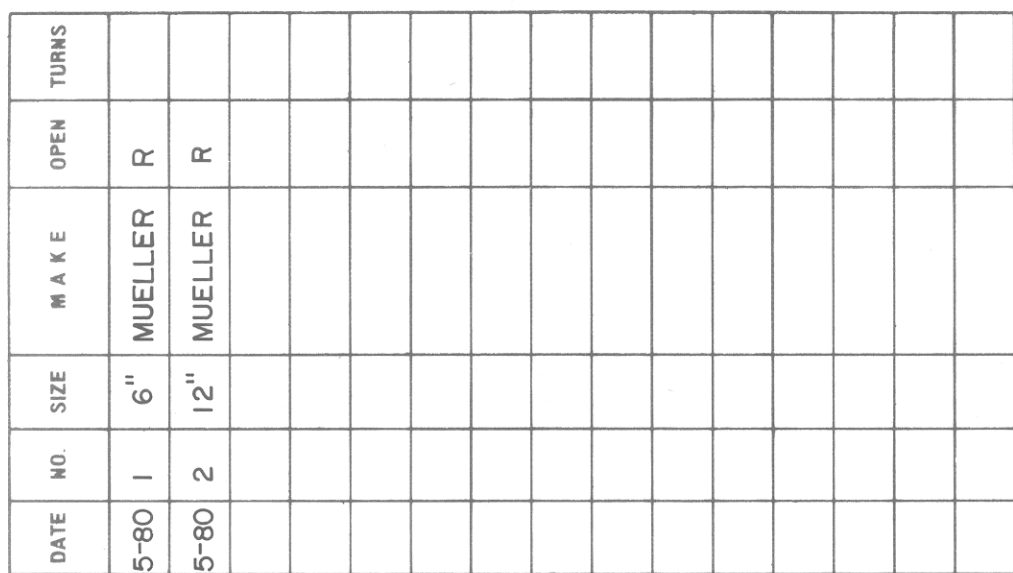

CITY OF ROANOKE—WATER DEPT
VALVE DIAGRAM

GUN CLUB ROAD 8

MELROSE AVENUE

NW

SEC. MAP 610, 611

DATE PAGE NO.