


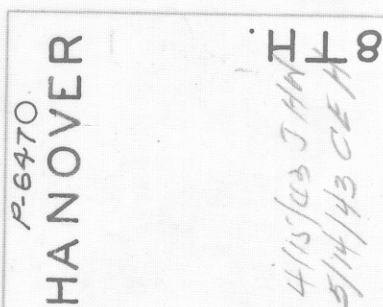

CITY OF ROANOKE—WATER DEPT
VALVE DIAGRAM

HANOVER AVE. & 8TH.
ST. N.W.

SEC. MAP 203

DATE PAGE NO. N.W. 56

[illegible]