


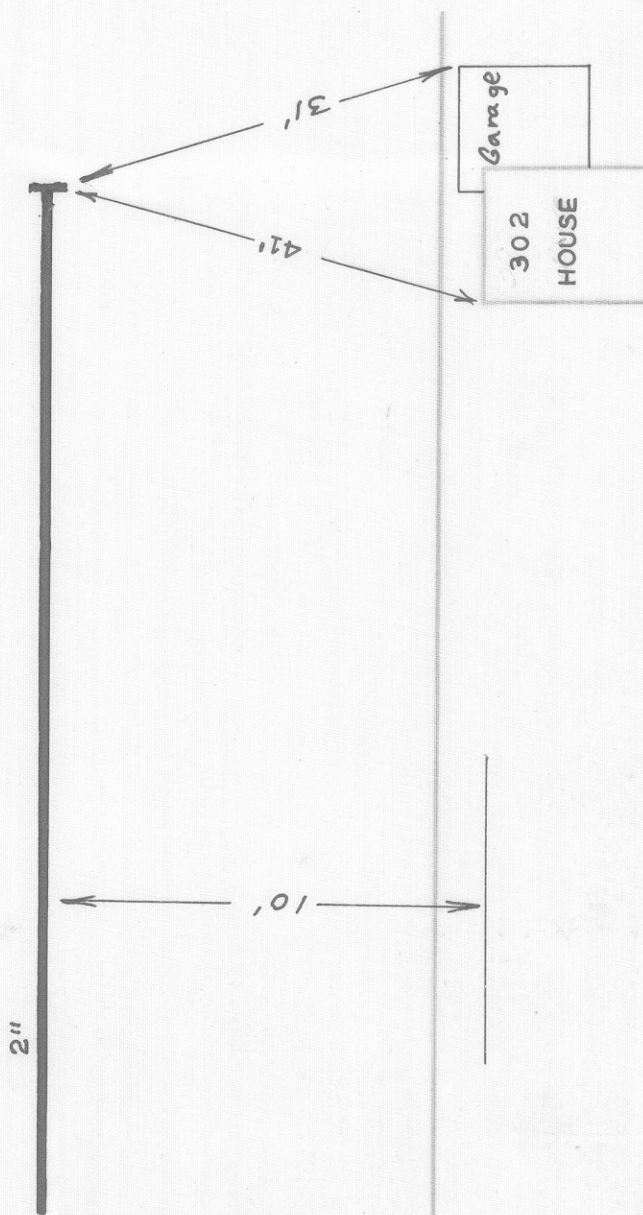

1 250'-W W P L QUARRY RD.

5TH. ST. N.W.

SEC. MAP 203

DATE 1/10/48

PAGE NO. NW 303