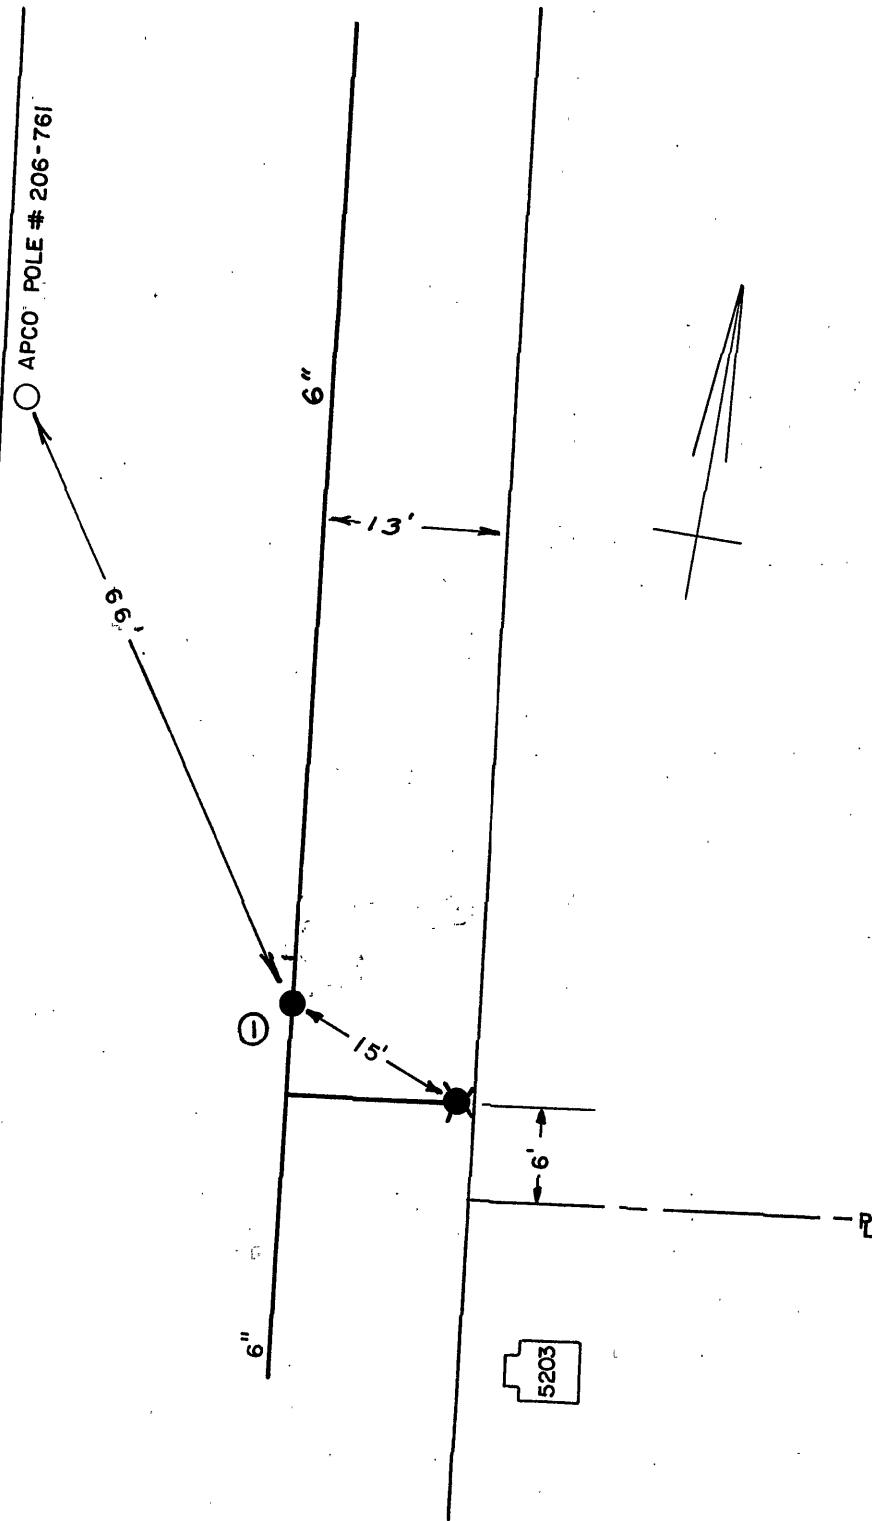


TRIAL" TRACING
X & E CO., N.Y.

5/94 NP

HEARTHSTONE ROAD

[illegible]

CITY OF ROANOKE—WATER DEPT.
VALVE DIAGRAM

HEARTHSTONE RD.
S. OF NELMS LANE N.W.

SEC. MAP 219

DATE:

PAGE NO.