


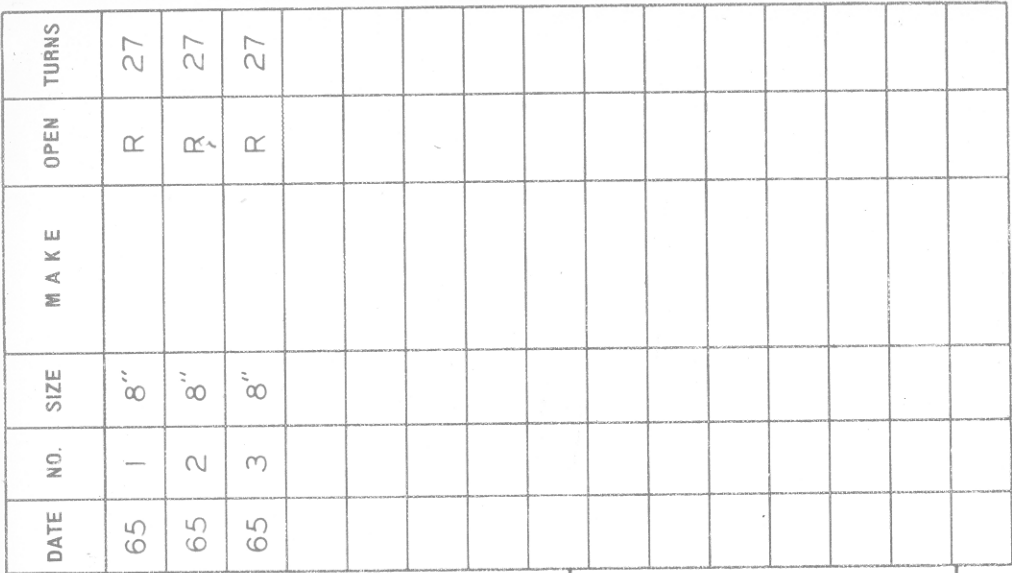

VALVE DIAGRAM

OAKLAND BOULEVARD N.E.

SEC. MAP 218

DATE SEP 1973 PAGE NO.