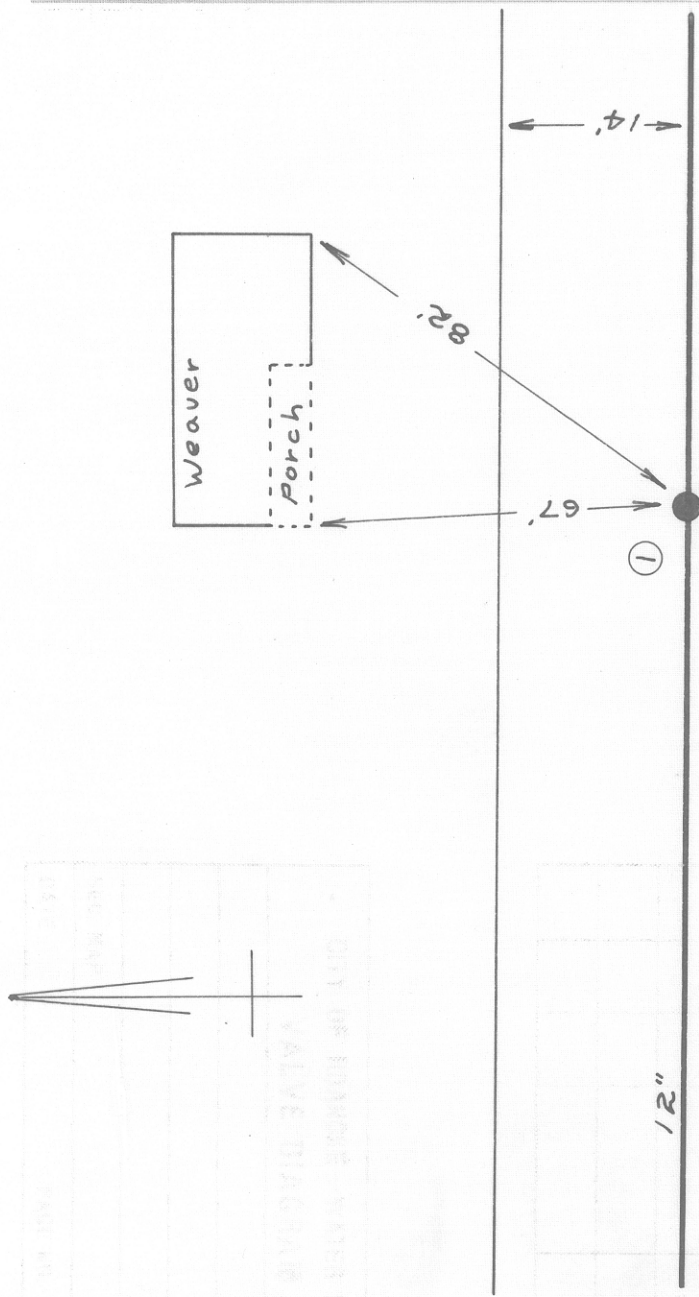


[illegible]

HERSHBERGER ROAD

FOR ROYCE — THE NEW

VALVE DIAGRAM

HERSHBERGER RD. 100'

EAST OF LICK RUN |

CREEK

SEC. MAP 249

DATE PAGE NO.