


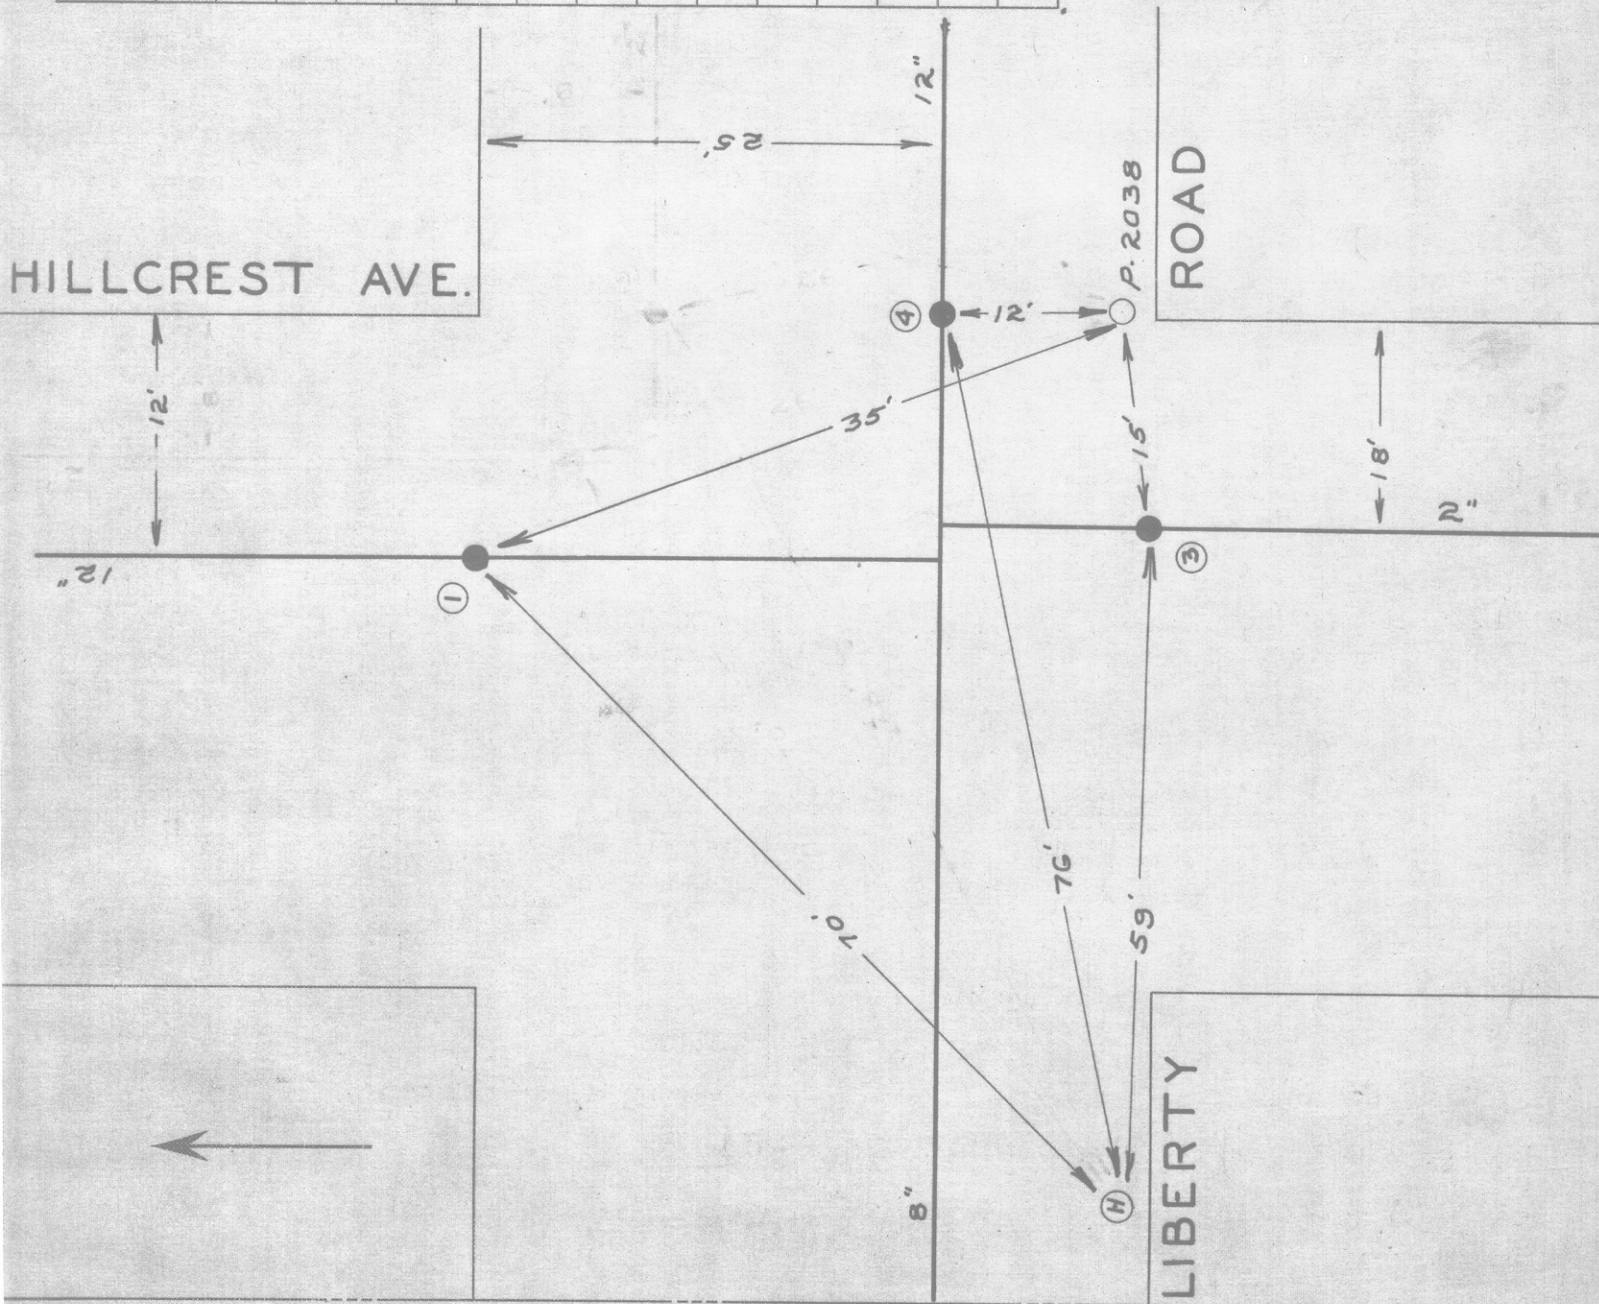

DATE	NO.	SIZE	MAKE	OPEN	TURNS
	1	12"	MUELLER	R	38
	2	12"	MUELLER	R	38
	3	2"			
	4	12"	DARLING	R	38
	5	12"			
	1	0	NPL		
	3	0	SPL		
	4	0	EPL		

CITY OF ROANOKE—WATER DEPT

VALVE DIAGRAM

HILLCREST AVE. &

LIBERTY ROAD N.W.

OR N.E. copy put

SEC. MAP 207-309

DATE

PAGE NO.