


DATE	NO.	SIZE	MAKE	OPEN	TURNS
	1	8"	MUELLER	R	27
	4	8"	MUELLER	R	27
	5	12"	MUELLER	R	38
	1	0	NPL		
	4	0	SPL		
	5	0	EPL		

CITY OF ROANOKE - WATER DEPT.	
VALVE DIAGRAM	
HILLCREST AVE. &	
LYNDHURST ST. N. W.	
SEC. MAP 207	
DATE	PAGE NO.

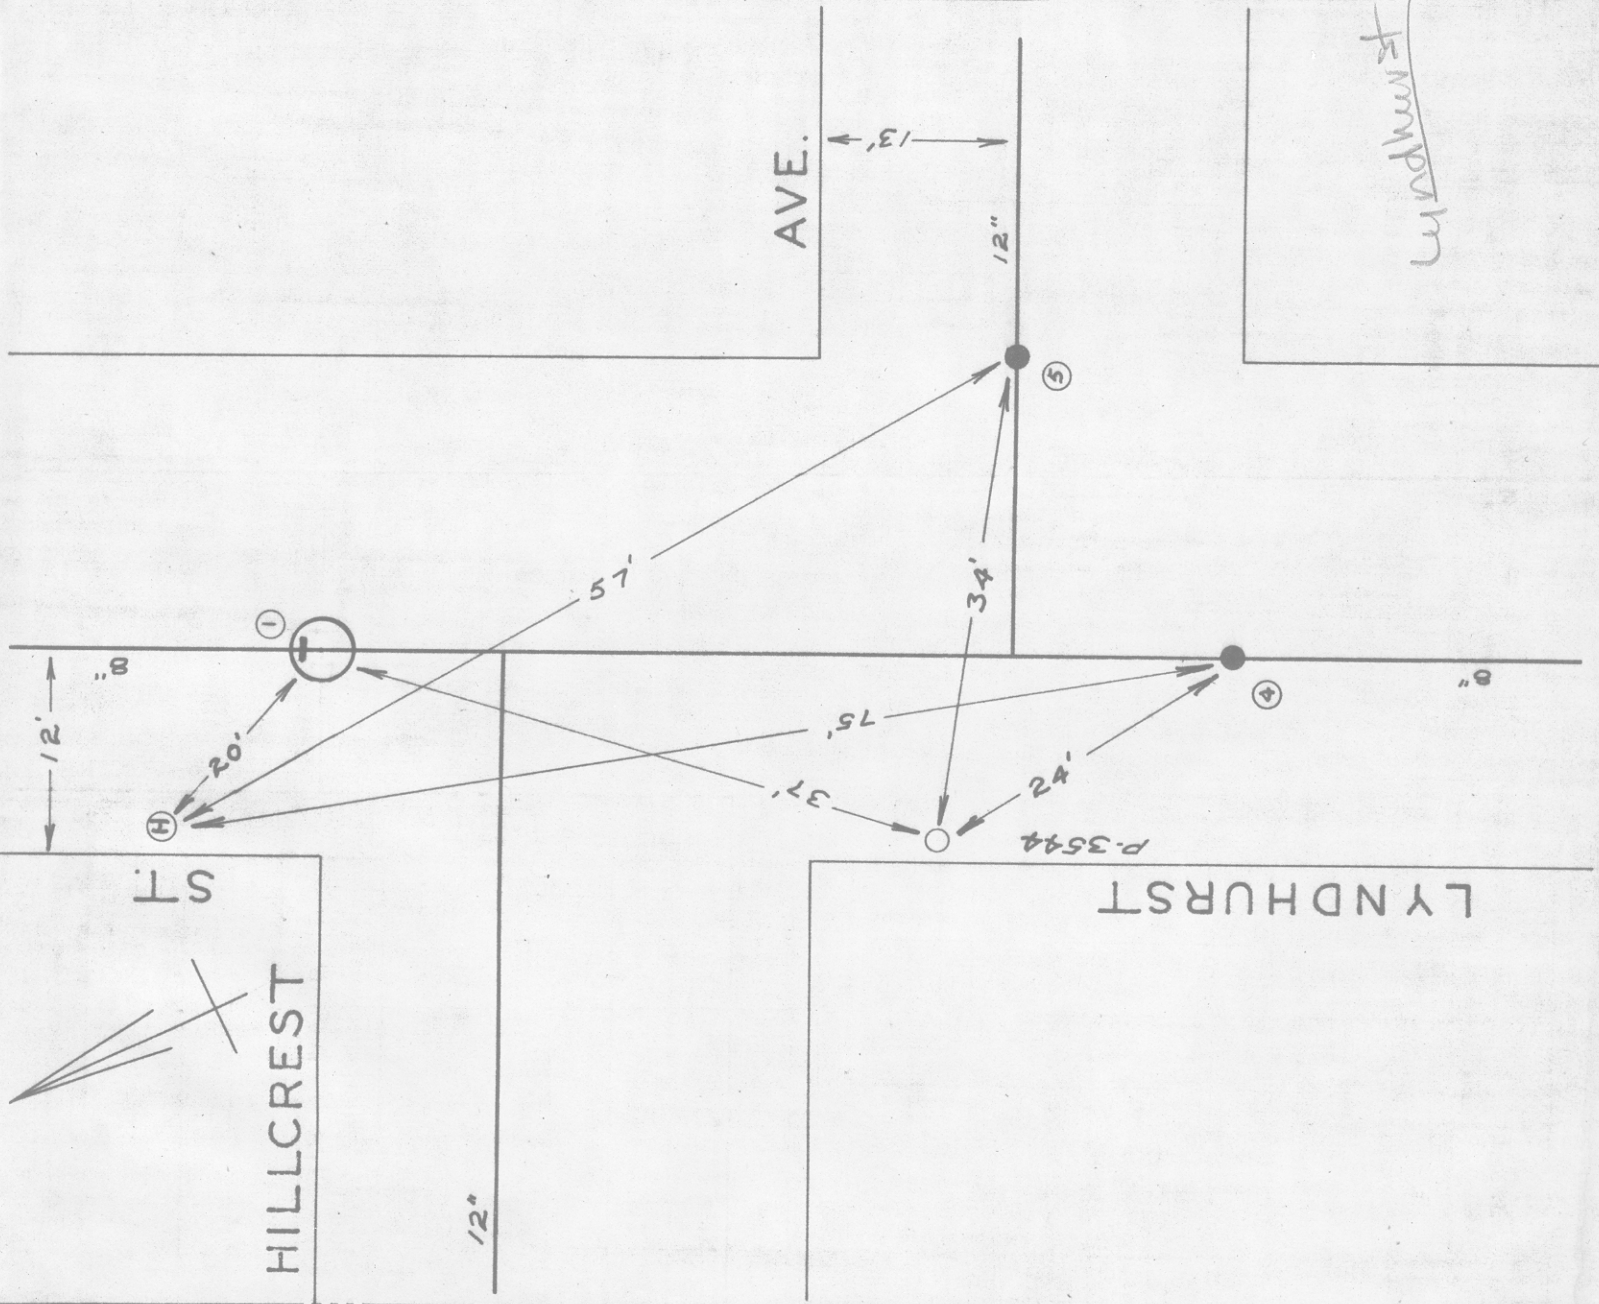

"IMPERIAL" TRACING CLOTH
K & E CO., N. Y.