


DATE	NO.	SIZE	MAKE	OPEN	TURNS
	1	6"			
	2	6"			
	4	6"	DARLING	R	20
	5	6"	DARLING	R	20
	6	6"	MUELLER	R	20
	1	3'-N	NPL		
	2	6'-E	WPL		
	4	10'-W	EPL		
	5	30'-E	WPL		
	6	24'-W	EPL		

CITY OF ROANOKE—WATER DEPT
VALVE DIAGRAM
HILLCREST AVE. &
OAKLAND BLVD. N.W.
SEC. MAP 215
DATE
PAGE NO.

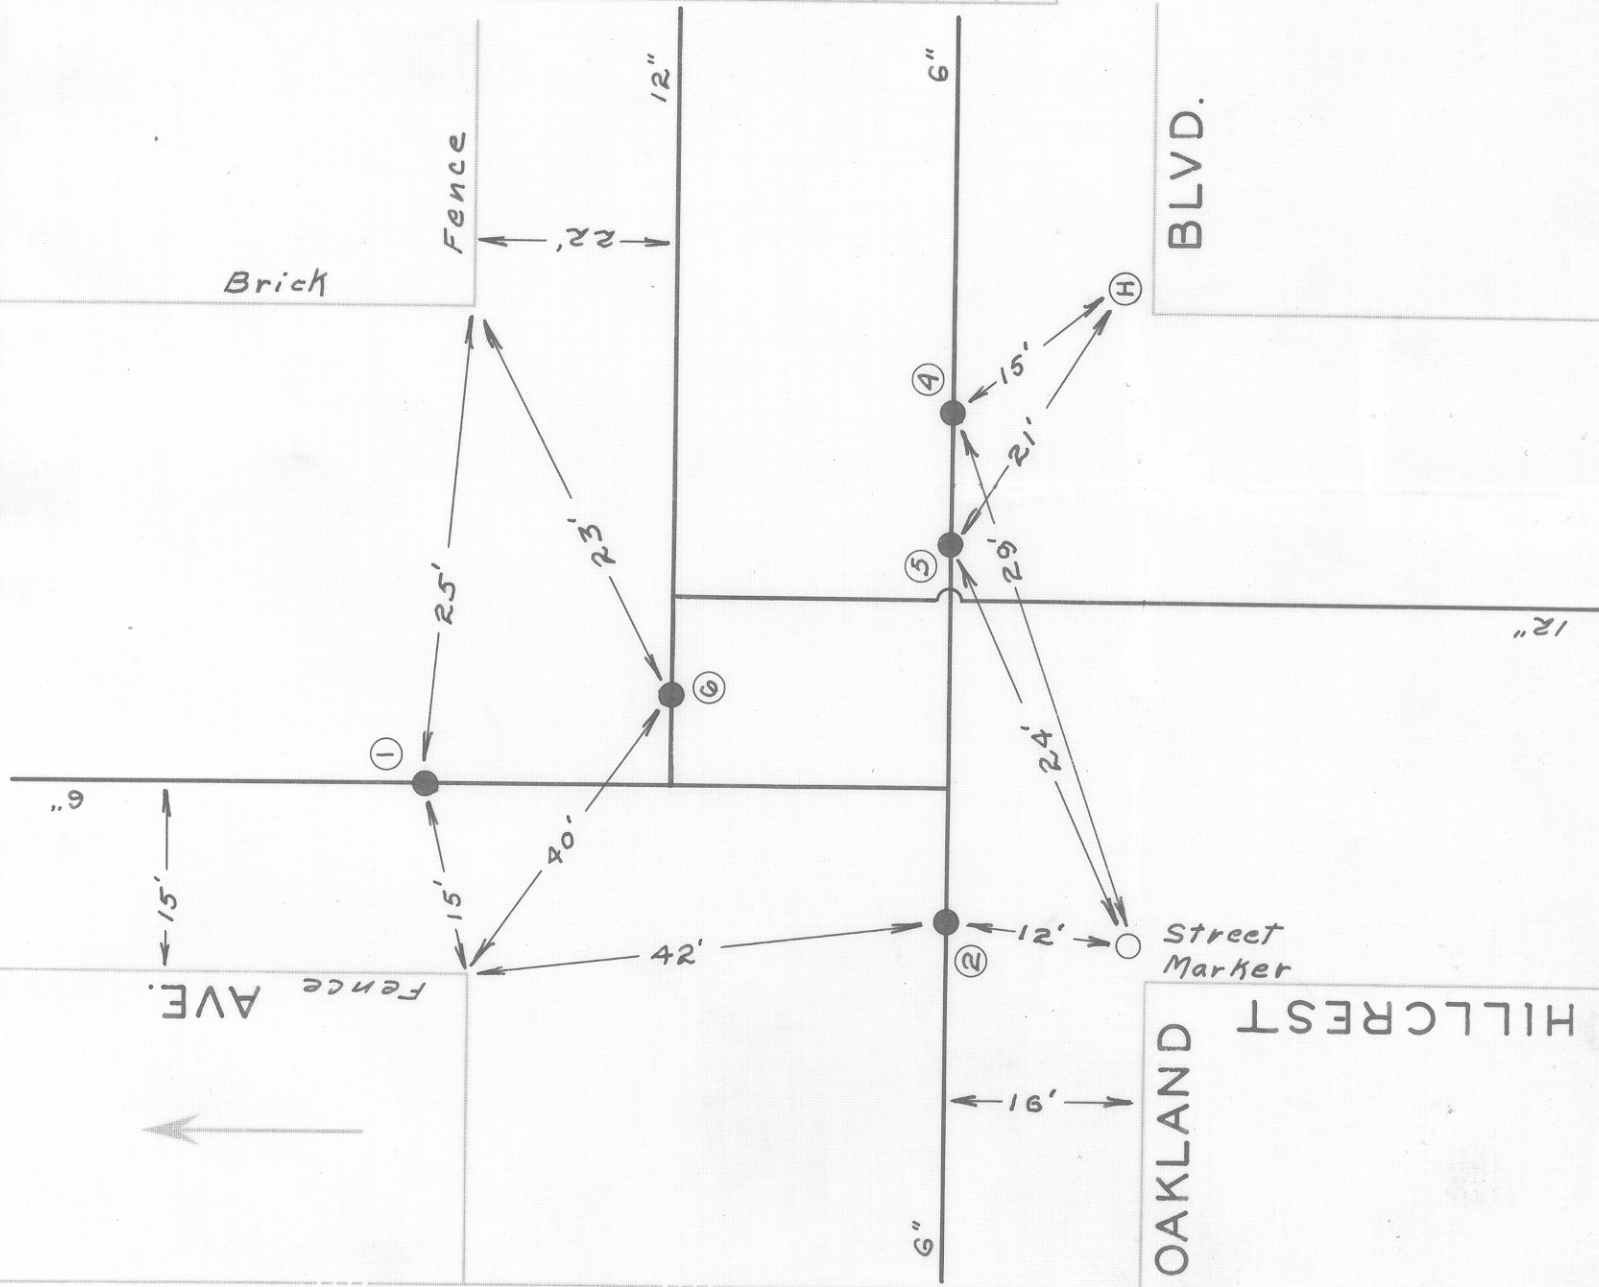

BLVD.

OAKLAND

HILLCREST

Street Marker