


RAVENWOOD AVE.

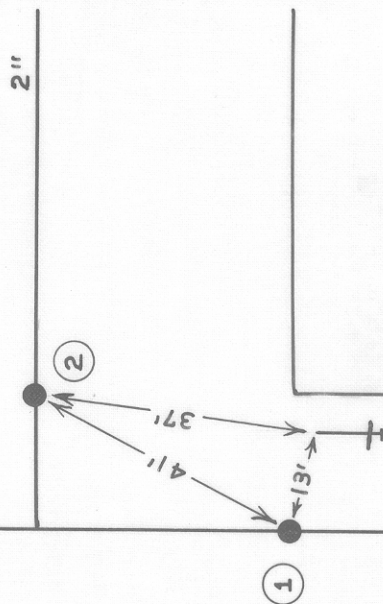

HUFF LANE

[illegible]

CITY OF ROANOKE -- WATER DEPT.

VALVE DIAGRAM

HUFF LANE &

RAVENWOOD AVENUE N.W.

SEC. MAP 226

DATE _____

PAGE NO.