


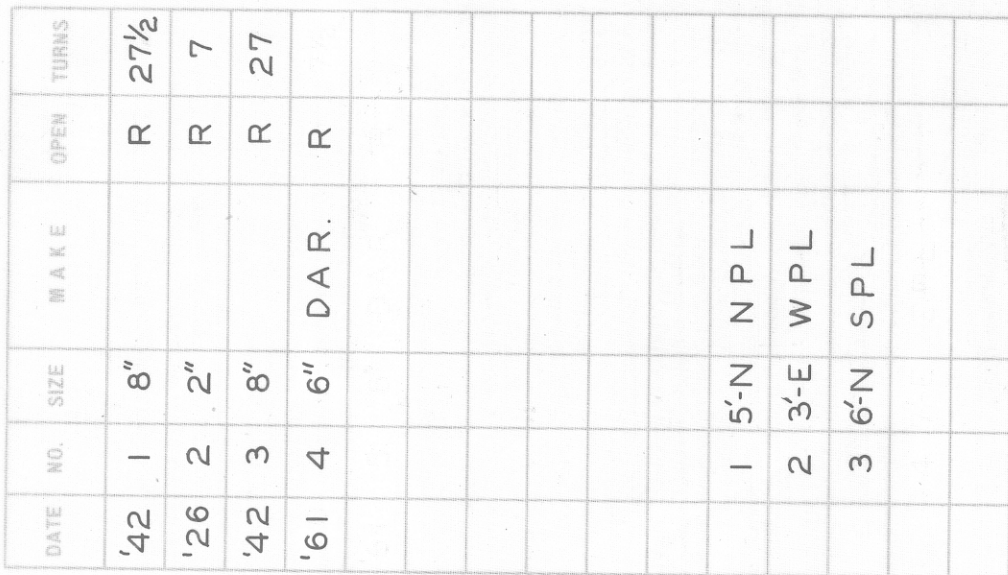

SEC. MAP 205