


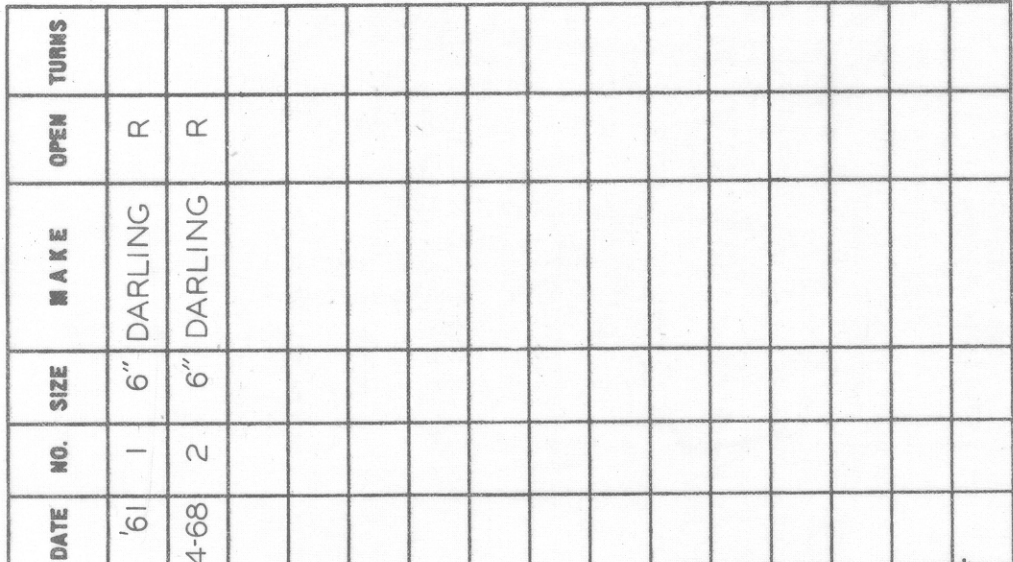

DATE	PAGE NO.
------	----------