


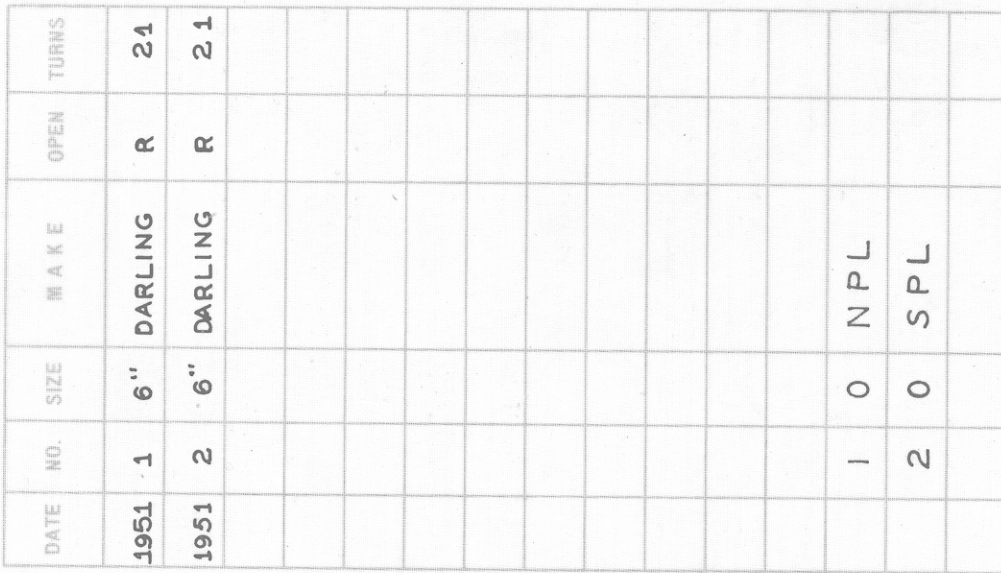

CITY OF ROANOKE—WATER DEPT	
VALVE DIAGRAM	
JOHNSTON AVENUE &	
25TH. STREET N.W.	
SEC. MAP	241
DATE	1/8/51
PAGE NO	NW 331