


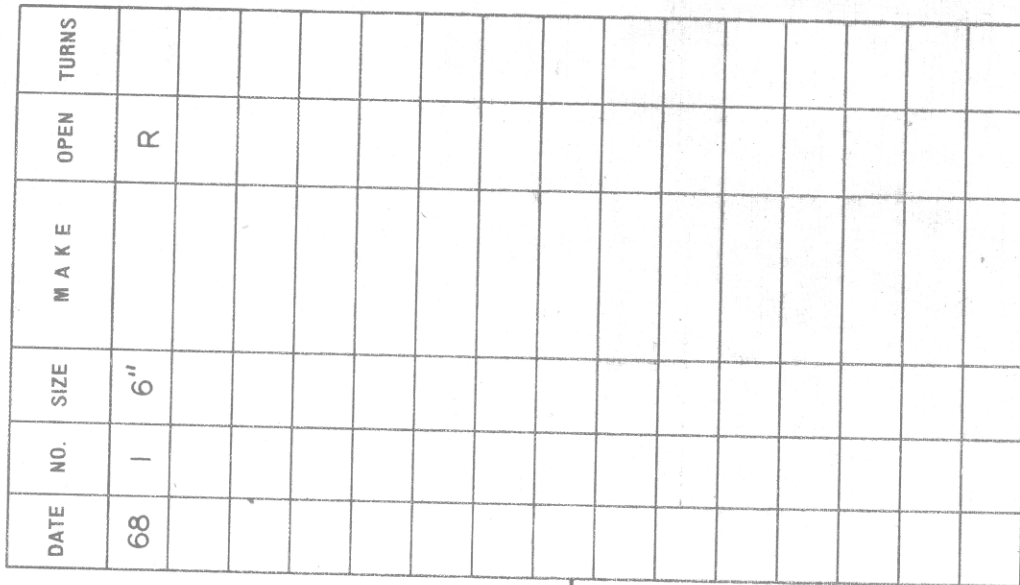

TELLICO ROAD N.W.

SEC. MAP 49

DATE PAGE NO.