


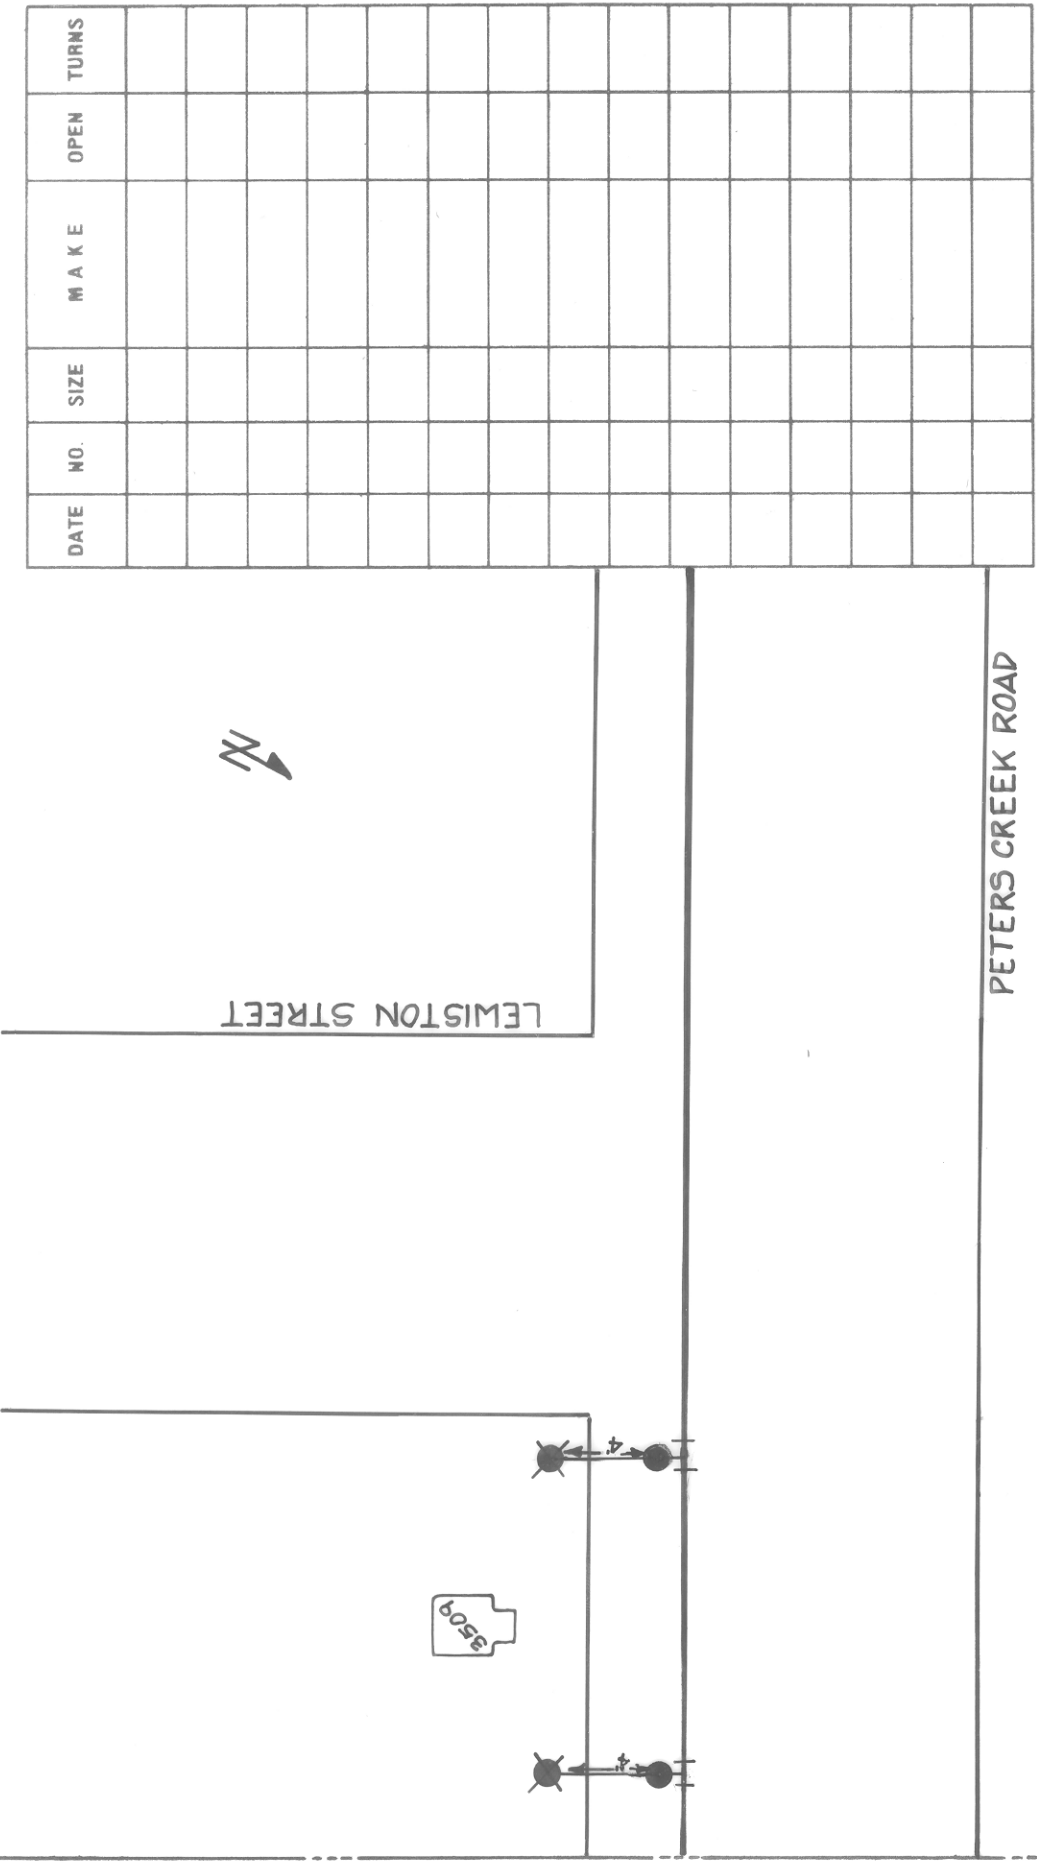

CITY OF ROANOKE—WATER DEPT					
VALVE DIAGRAM					
LEWISTON STREET AND					
PETERS CREEK ROAD					
N.W.					
SEC. MAP 642					
DATE NOV. 28, 1980 PAGE NO.					