


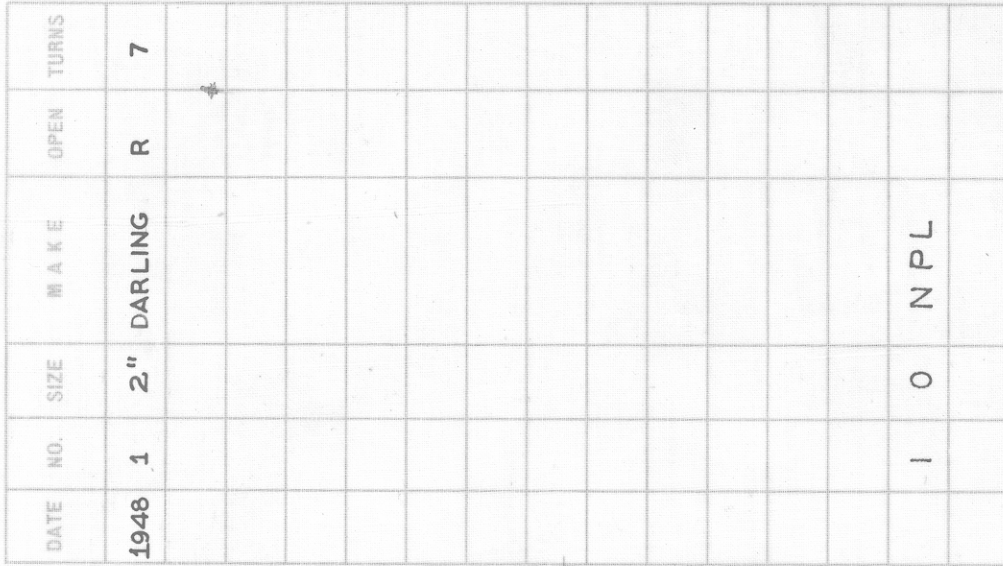

CITY OF ROANOKE—WATER DEPT				
VALVE DIAGRAM				
LIBERTY ROAD &				
MEADOWS STREET				N.W.
SEC. MAP	207			
DATE	4/14/48			
				PAGE NO NW 306